

WATER RESOURCES ADMINISTRATION  
 STATE OFFICE BLDG., ANNEAPOLIS, MD. 21401  
**WELL COMPLETION REPORT**

FILL IN THIS FORM COMPLETELY  
 COUNTY NUMBER **A18221**

DATE WELL COMPLETED **11-12-13**  
 DEPTH OF WELL **20**  
 PERMIT NO. FROM "PERMIT TO DRILL WELL"  
**AD-73-0712**  
 DRILLERS IDENTIFICATION NO. **47**

OWNER **Anderson R. E.**  
 STREET OR RFD \_\_\_\_\_ POST OFFICE **Northville, Md.**

**WELL LOG**  
 STATE THE KIND OF FORMATIONS PENETRATED, THEIR COLOR, DEPTH, THICKNESS AND IF WATER BEARING

DESCRIPTION (USE ADDITIONAL SHEETS IF NECESSARY)	FEET		CHECK IF WATER BEARING
	FROM	TO	
<i>Impervious</i>	0	20	+
<i>Sandy</i>	20	34	✓
<i>Lo. S. Stone</i>	34	96.0	
<i>Gravel</i>			

**GRouting RECORD**  
 WELL HAS BEEN GROUTED (CIRCLE APPROPRIATE BOX)  
 Y  N

TYPE OF GROUTING MATERIAL (CIRCLE BOX)  
 CM CEMENT  BC BENTONITE CLAY

NO. OF BARS **6** NO. OF POUNDS **600**

BALLONS OF WATER **36**

DEPTH OF GROUT SEAL (TO NEAREST FOOT)  
 FROM **0** FT. TO **21** FT.  
 (ENTER 0 IF FROM SURFACE)

**CASING RECORD**  
 INSERT APPROPRIATE CODE BELOW

MAIN CASING TYPE  S  T  
 NOMINAL DIAMETER TOP MAIN CASING (NEAREST INCH) **6**  
 TOTAL DEPTH OF MAIN CASING (NEAREST FOOT) **25**

**OTHER CASING (IF USED)**  
 DIAMETER (INCH) \_\_\_\_\_ DEPTH (FEET) FROM \_\_\_\_\_ TO \_\_\_\_\_

**SCREEN RECORD**  
 SCREEN TYPE OR OPEN HOLE? (INSERT APPROPRIATE CODE BELOW)

S STEEL  BR BRASS OR BRONZE  HO OPEN HOLE  
 PL PLASTIC  OT OTHER

**DEPTH (NEAREST WHOLE FOOT)**  
 FROM \_\_\_\_\_ TO \_\_\_\_\_

SCREEN \_\_\_\_\_

BLD SIZE 1. \_\_\_\_\_ 2. \_\_\_\_\_ 3. \_\_\_\_\_

DIAMETER OF SCREEN **5.5** (NEAREST INCH)  
 FROM \_\_\_\_\_ TO \_\_\_\_\_

GRAVEL PACK \_\_\_\_\_

IF WELL DRILLED WAS A FLOWING WELL (CIRCLE BOX)  F

DRIVER USE ONLY (NOT TO BE FILLED IN BY DRILLER)

TELESCOPE CARING  YES  NO  
 LOG INDICATOR  YES  NO  
 OTHER DATA AVAILABLE \_\_\_\_\_

**PUMPING TEST**  
 HOURS PUMPED (TO NEAREST HOUR) **2**  
 PUMPING RATE (GALLONS PER MINUTE TO NEAREST GALLON) **1**  
 METHOD USED TO MEASURE PUMPING RATE **Imp. Pit**

WATER LEVEL (DISTANCE FROM LAND SURFACE)  
 BEFORE PUMPING **75** (NEAREST FOOT)  
 WHEN PUMPING **76.0** (NEAREST FOOT)

TYPE OF PUMP USED (CIRCLE APPROPRIATE BOX) (FOR PUMPING TEST)  
 A AIR  P PISTON  T TURBINE  
 C CENTRIFUGAL  R ROTARY  O OTHER (DESCRIBE BELOW)  
 J JET  S SUBMERSIBLE

**PUMP INSTALLED**  
 TYPE OF PUMP (INSERT APPROPRIATE LETTER IN BOX - SEE ABOVE: A, C, J, P, R, S, T, O)


DRILLER WILL INSTALL PUMP (CIRCLE APPROPRIATE BOX)  YES  NO

CAPACITY: GALLONS PER MINUTE (TO NEAREST GALLON) \_\_\_\_\_

PUMP HORSE POWER \_\_\_\_\_

PUMP COLUMN LENGTH (NEAREST FOOT) **48** **47**

**CASING HEIGHT** (CIRCLE APPROPRIATE BOX AND ENTER CASING HEIGHT)  
 ABOVE LAND SURFACE  
 BELOW **2** (NEAREST FOOT)

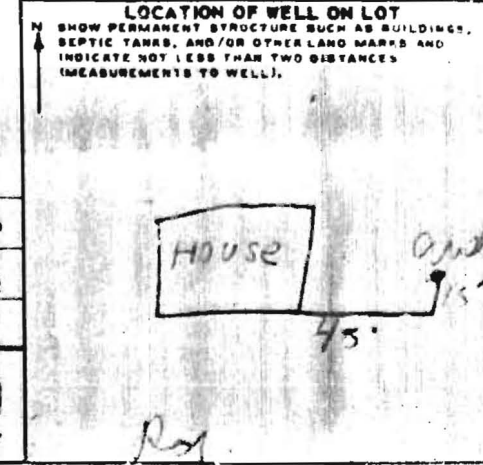

**CIRCLE APPROPRIATE BOXES**

A WELL WAS ABANDONED AND SEALED WHEN THIS WELL WAS COMPLETED

E ELECTRIC LOG OBTAINED

P TEST WELL CONVERTED TO PRODUCTION WELL

I HEREBY CERTIFY THAT I HAVE COMPLIED WITH ALL CONDITIONS STATED ON THE ABOVE CAPTIONED "PERMIT TO DRILL WELL", AND THAT INFORMATION CONTAINED IN THIS REPORT IS TRUE, ACCURATE, AND COMPLETE TO THE BEST OF MY KNOWLEDGE, INFORMATION AND BELIEF.

DRILLERS NAME **J. J. ...**

PLEASE PRINT: \_\_\_\_\_

SIGNATURE: \_\_\_\_\_