

WELL COMPLETION REPORT

DATE WELL COMPLETED: 7-3-77

DEPTH OF WELL: 100

DRILLER'S IDENTIFICATION NO.: 277

OWNER: SNYDER

STREET OR RFD: GLEN BLIRNIE

POST OFFICE: GLEN BURNIE

WELL LOG

STATE THE KIND OF FORMATIONS PENETRATED, THEIR COLOR, DEPTH, THICKNESS AND IF WATER BEARING

DESCRIPTION (USE ADDITIONAL SHEETS IF NECESSARY)	FEET		WATER BEARING
	FROM	TO	
GRAY SAND STONE	6	100	✓

**GRouting RECORD**

WELL HAS BEEN GROUTED (CIRCLE APPROPRIATE BOX)  Y  N

TYPE OF GROUTING MATERIAL (CIRCLE BOX)  ST  BC

REINVENT  ST  BC

NO. OF BAGS: 5 NO. OF POUNDS: 470

GALLONS OF WATER: 30

DEPTH OF GROUT SEAL (TO NEAREST FOOT)

FROM 0 FT. TO 20 FT.

**CASING RECORD**

CASING TYPE:  ST  CO  PL  OT

MAIN CASING TYPE:  ST

NOMINAL DIAMETER (NEAREST INCH): 6

TOTAL DEPTH OF MAIN CASING (NEAREST FOOT): 21

**OTHER CASING (IF USED)**

DIAMETER (INCH) \_\_\_\_\_ DEPTH (FEET) FROM \_\_\_\_\_ TO \_\_\_\_\_

**SCREEN RECORD**

SCREEN TYPE (CIRCLE APPROPRIATE CODE BELOW):  ST  BR  PL  OT

STEEL OR BRASS OR OTHER

**DEPTH OF WELL**

DEPTH (NEAREST WHOLE FOOT) FROM \_\_\_\_\_ TO \_\_\_\_\_

1 2 3 100

**PUMPING TEST**

HOURS PUMPED (TO NEAREST HOUR): 2

PUMPING RATE (GALLONS PER MINUTE TO NEAREST GALLON): 20

METHOD USED TO MEASURE PUMPING RATE: ROTARY

WATER LEVEL (DISTANCE FROM LAND SURFACE)

BEFORE PUMPING: 35 (NEAREST FOOT)

WHEN PUMPING: 95 (NEAREST FOOT)

TYPE OF PUMPED USED (CIRCLE APPROPRIATE BOX FOR PUMPING TEST):  C  P  T  J  S

**PUMP INSTALLED**

TYPE OF PUMP (WRITE APPROPRIATE LETTER IN BOX - SEE ABOVE: A, C, J, P, R, S, T, O)

DRILLER WILL INSTALL PUMP (CIRCLE APPROPRIATE BOX):  Y  N

CAPACITY:

GALLONS PER MINUTE (TO NEAREST GALLON): \_\_\_\_\_


PUMP HORSE POWER: \_\_\_\_\_

PUMP COLUMN LENGTH (NEAREST FOOT): \_\_\_\_\_

**CASING HEIGHT** (CIRCLE APPROPRIATE BOX AND ENTER CASING HEIGHT)

ABOVE  BELOW

LAND SURFACE (NEAREST FOOT): \_\_\_\_\_

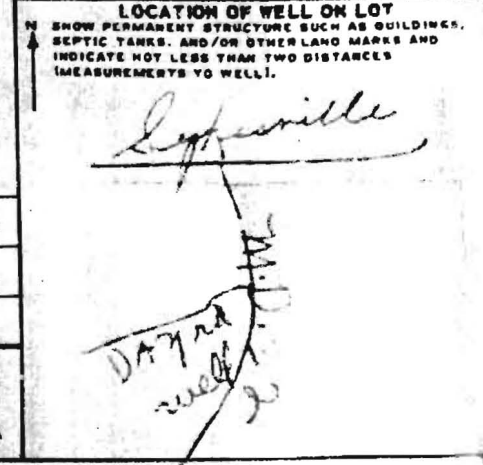

**CIRCLE APPROPRIATE BOXES**

A WELL WAS ABANDONED AND SEALED WHEN THIS WELL WAS COMPLETED

B ELECTRIC LOG OBTAINED

C TEST WELL CONVERTED TO PRODUCTION WELL

I HEREBY CERTIFY THAT I HAVE COMPLIED WITH ALL CONDITIONS STATED ON THE ABOVE-CAPTIONED "PERMIT TO DRILL WELL", AND THAT INFORMATION CONTAINED IN THIS REPORT IS TRUE, ACCURATE, AND COMPLETE TO THE BEST OF MY KNOWLEDGE, INFORMATION AND BELIEF.

DRILLER'S NAME: RAY KEYSER

SIGNATURE: Ray Keyser

DIAMETER OF SCREEN (NEAREST INCH): \_\_\_\_\_

BRAND NAME: \_\_\_\_\_

IF WELL DRILLED WAS A FLOWING WELL (CIRCLE BOX):  Y  N

WHA USE ONLY (NOT TO BE FILLED IN BY DRILLER)

TELESCOPE CASING:  70  71  72

LOG INDICATOR:  73  74  75  76

OTHER DATA AVAILABLE:  77  78

LOT 3  
FRANCIS HEDER PROPERTY  
TOWN OF ...  
...  
... 1917

Geological Conditions

...  
...  
INV EL AT TRNK 3920  
INV EL AT HOUSE 3925

8/30/20 ...  
B. 15

390

390

W. 55' ...

392

W. 50' ...