

C1 1450 SEQUENCE NO. (DENY USE ONLY)

STATE OF MARYLAND
WELL COMPLETION REPORT
FILL IN THIS FORM COMPLETELY
PLEASE PRINT OR TYPE

THIS REPORT MUST BE SUBMITTED WITHIN
45 DAYS AFTER WELL IS COMPLETED.
COUNTY NUMBER A06296

ST/CO USE ONLY
DATE RECEIVED
DATE WELL COMPLETED

Depth of Well
22 200 28
(TO NEAREST FOOT)

PERMIT NO.
FROM "PERMIT TO DRILL WELL"
12/26/71 402-781-1926

OWNER last name first name TOWN
STREET OR RFD
SUBDIVISION SECTION LOT

WELL LOG
Not required for driven wells
STATE THE KIND OF FORMATIONS
PENETRATED, THEIR COLOR, DEPTH,
THICKNESS AND IF WATER BEARING

DESCRIPTION (Use additional sheets if needed)	FEET		Check if water bearing
	FROM	TO	
TOP SOIL	0	2	
Silt & clay	2	8	
Shaly	8	15	
Sandstone	15	21	
Mica	21	33	
Sandstone	33	35	
Mica	35	42	
Sandstone	42	45	
Mica	45	55	
Sandstone	55	57	
Mica	57	200	

location approx. anywhere
20' in front of house
7-31-91 C.C.

Sept. 11, 1991. find out about (C.O.P.)
8-14-91. find my sample bottle

ROUTING RECORD
WELL HAS BEEN GROUTED (Circle appropriate box)
TYPE OF GROUTING MATERIAL
CEMENT CM BENTONITE CLAY BC
NO. OF BAGS NO. OF POUNDS
GALLONS OF WATER
DEPTH OF GROUT SEAL (to nearest foot)
from 0 ft. to 0 ft.
(enter 0 if from surface)

CASING RECORD
casing type insert appropriate code below
ST CO STEEL CONCRETE
PL OT PLASTIC OTHER
MAIN CASING TYPE
Nominal diameter top (main) casing (nearest inch)
Total depth of main casing (nearest foot)
ST 6 38

OTHER CASING (if used)
diameter inch depth (feet) to

SCREEN RECORD
screen type or open hole insert appropriate code below
ST BR HO STEEL BRASS OPEN HOLE
PL CT PLASTIC OTHER

C2


SCREEN	DEPTH (nearest ft.)	
	1	2
1	200	200
2		
3		

SLOT SIZE 1 2 3
DIAMETER OF SCREEN (NEAREST INCH)
from to

GRAVEL PACK IF WELL DRILLED WAS FLOWING WATER INSERT
DEP USE ONLY (NOT TO BE FILLED IN BY DRILLER)
TELESCOPE CASING LOG INDICATOR OTHER DATA

C3
PUMPING TEST
HOURS PUMPED (nearest hour) 5
PUMPING RATE (gal. per min. to nearest gal.)
METHOD USED TO MEASURE PUMPING RATE BUCKET
WATER LEVEL (distance from land surface)
BEFORE PUMPING 55
WHEN PUMPING 200
TYPE OF PUMP USED (for test)
A piston T turbine
C centrifugal R rotary C other (describe below)
J jet S submersible

PUMP INSTALLED
DRILLER WILL INSTALL PUMP YES NO
(CIRCLE) (YES or NO)
IF DRILLER INSTALLS PUMP, THIS SECTION MUST BE COMPLETED FOR ALL WELLS EXCEPT HOME USE
TYPE OF PUMP INSTALLED PLACE (A,C,J,P,R,S,T,O) IN BOX - SEE ABOVE:
CAPACITY: GALLONS PER MINUTE (to nearest gallon)
PUMP HORSE POWER
PUMP COLUMN LENGTH (nearest ft.)
CASING HEIGHT (circle appropriate box)
LAND SURFACE (nearest foot)

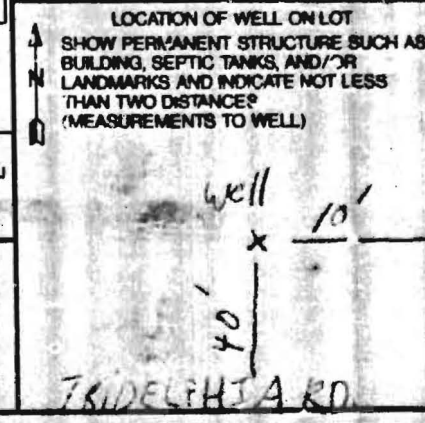

CIRCLE APPROPRIATE LETTER
A A WELL WAS ABANDONED AND SEALED WHEN THIS WELL WAS COMPLETED
E ELECTRIC LOG OBTAINED
P TEST WELL CONVERTED TO PRODUCTION WELL

I HEREBY CERTIFY THAT THIS WELL HAS BEEN CONSTRUCTED IN ACCORDANCE WITH COMAR 26.04.04 "WELL CONSTRUCTION AND IN CONFORMANCE WITH ALL CONDITIONS STATED IN THE ABOVE CAPTIONED PERMIT, AND THAT THE INFORMATION FURNISHED HEREIN IS ACCURATE AND COMPLETE TO THE BEST OF MY KNOWLEDGE

DRILLERS IDENT. NO.
DRILLERS SIGNATURE (MUST MATCH SIGNATURE ON APPLICATION)
SITE SUPERVISOR (sign of driller or journeyman responsible for sitework if different from permittee)

COUNTY