

C 1 2276
 SEQUENCE NO. (IDW/USE ONLY)
 1 2 3 (SEQ. NO.) 6
 THIS NUMBER IS TO BE PUNCHED IN COLS. 3-6 ON ALL CARDS

STATE OF MARYLAND
 WATER RESOURCES ADMINISTRATION
 TAWES STATE OFFICE BLDG., ANNAPOLIS, MD. 21401
 WELL COMPLETION REPORT

THIS REPORT MUST BE SUBMITTED WITHIN 30 DAYS AFTER WELL COMPLETION
 FILL IN THIS FORM COMPLETELY
 COUNTY NUMBER

DATE RECEIVED (IDW/USE ONLY) _____
 DATE WELL COMPLETED 4/15/73
 DEPTH OF WELL 100 (TO NEAREST FOOT) 22 26
 PERMIT NO. FROM "PERMIT TO DRILL WELL" _____
 28 29 30 31 32 33 34 35 36 37
 DRILLERS IDENTIFICATION NO. 209

OWNER LOFTICE LARRY
 LAST NAME FIRST NAME
 STREET OR RFD 815 MIDDLESEX RD POST OFFICE FALTON 21221

WELL LOG
 STATE THE KIND OF FORMATIONS PENETRATED, THEIR COLOR, DEPTH, THICKNESS AND IF WATER BEARING
 DESCRIPTION FEET CHECK IF WATER BEARING
 USE ADDITIONAL SHEETS IF NECESSARY

White Sand 0 68'
White Rock 68 150' X

WELL DESCRIPTION
 GROUTING RECORD
 WELL HAS BEEN GROUTED (CIRCLE APPROPRIATE BOX) Y N
 YES NO
 44 44
 TYPE OF GROUTING MATERIAL (CIRCLE BOX)
 CEMENT CM BC BENTONITE CLAY
 45 46 45 46
 NO. OF BAGS Y NO. OF POUNDS 725
 GALLONS OF WATER 80
 DEPTH OF GROUT SEAL (TO NEAREST FOOT)
 FROM 0 FT. TO 30 FT.
 48 52 54 58
 ENTER 0 IF FROM SURFACE

CASING RECORD
 CASING TYPES (INSERT APPROPRIATE CODE BELOW)
 S STEEL C CONCRETE
 P PLASTIC O OTHER
 MAIN CASING TYPE S NOMINAL DIAMETER TOP MAIN CASING (NEAREST INCH) 6 TOTAL DEPTH OF MAIN CASING (NEAREST FOOT) 68
 60 61 63 64 66 70

OTHER CASING (IF USED)
 DIAMETER (INCH) DEPTH (FEET) FROM TO
 [] [] [] [] [] [] [] [] [] []

SCREEN RECORD
 SCREEN TYPE OR OPEN HOLE (INSERT APPROPRIATE CODE BELOW)
 S STEEL B BRASS OR BRONZE H OPEN HOLE
 P PLASTIC O OTHER


C 2
 1 2 3 (SEQ. NO.) 6
 DEPTH NEAREST WHOLE FOOT FROM TO
 8 9 11 15 17 21
 23 24 26 30 32 36
 38 41 45 47 51
 SLOT SIZE 1. 2. 3.

DIAMETER OF SCREEN 5 1/2 NEAREST INCH FROM TO
 SPACEL PACK _____
 IF WELL DRILLED WAS A FLOWING WELL (CIRCLE BOX) F

DRILLERS NAME
TOWARD DILLON
James T. Dillon
 TELESCOPE LOG INDICATOR
 T L W
 70 72 74 75 76
 OTHER DATA AVAILABLE

C 3
 1 2 3 (SEQ. NO.) 6
 PUMPING TEST
 HOURS PUMPED (TO NEAREST HOUR) 6
 8 9
 PUMPING RATE (GALLONS PER MINUTE TO NEAREST GALLON) 10
 11 15
 METHOD USED TO MEASURE PUMPING RATE TIME
 WATER LEVEL: (DISTANCE FROM LAND SURFACE)
 BEFORE PUMPING 35 (NEAREST FOOT)
 17 21
 WHEN PUMPING 1:15 (NEAREST FOOT)
 22 25
 TYPE OF PUMP USED (CIRCLE APPROPRIATE BOX) (FOR PUMPING TEST)
 A AIR P PISTON T TURBINE
 27 27 27
 C CENTRIFUGAL R ROTARY O OTHER (DESCRIBE BELOW)
 27 27 27
 J JET S SUBMERSIBLE
 27 27

PUMP INSTALLED
 TYPE OF PUMP (WRITE APPROPRIATE LETTER IN BOX - SEE ABOVE: A, C, J, P, R, S, T, O)
 29
 DRILLER WILL INSTALL PUMP (CIRCLE APPROPRIATE BOX) Y N
 CAPACITY:
 GALLONS PER MINUTE (TO NEAREST GALLON) _____
 31 35
 PUMP HORSE POWER _____
 37 41
 PUMP COLUMN LENGTH (NEAREST FOOT) _____
 43 47
 CASING HEIGHT (CIRCLE APPROPRIATE BOX AND ENTER CASING HEIGHT)
 + ABOVE } LAND SURFACE
 - BELOW } (NEAREST FOOT)
 49 50 51

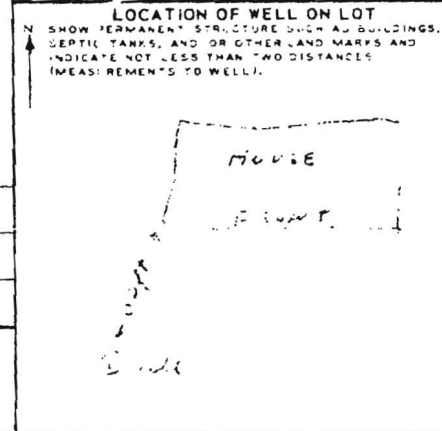

CIRCLE APPROPRIATE BOXES
 A WELL WAS ABANDONED AND SEALED WHEN THIS WELL WAS COMPLETED
 E ELECTRIC LOG OBTAINED
 TEST WELL CONVERTED TO PRODUCTION WELL
 I HEREBY CERTIFY THAT I HAVE COMPLIED WITH ALL CONDITIONS STATED ON THE ABOVE MENTIONED "PERMIT TO DRILL WELL" AND THAT INFORMATION CONTAINED IN THIS REPORT IS TRUE, ACCURATE, AND COMPLETE TO THE BEST OF MY KNOWLEDGE, INFORMATION AND BELIEF.
 DRILLERS NAME
TOWARD DILLON
James T. Dillon