




INDIAN HILL  
 LOT #37  
 HOWARD LODGE DRIVE

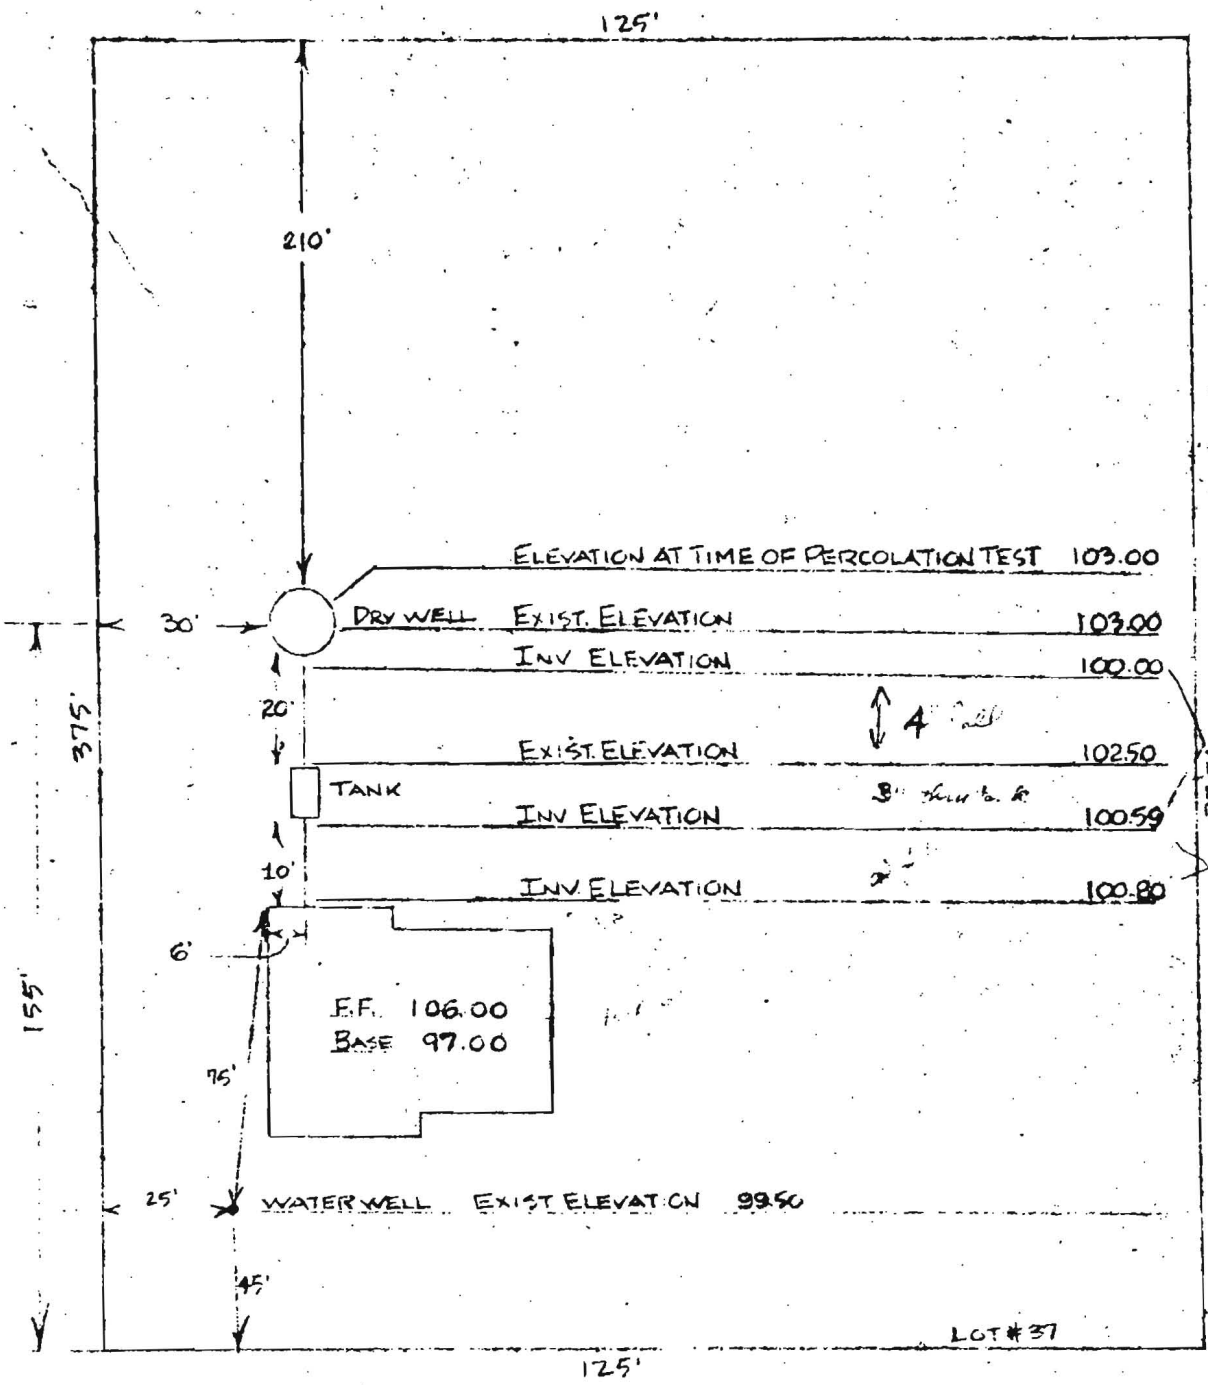

4-2-75  
 P. W. [Signature]

HOWARD LODGE DRIVE

I CERTIFY THE ABOVE MEASUREMENTS AND ELEVATION DIFFERENCES ARE ACTUAL  
 AND CORRECT FOR THIS PROPERTY

WITNESSED AND CORRECTED