

12605 HOWARD LODGE ROAD

PERMIT

P 18461
A 12090

SEWAGE DISPOSAL SYSTEM

MARYLAND STATE DEPARTMENT OF HEALTH

HOWARD COUNTY

ELLICOTT CITY

DISTRICT 3rd

INDEXED

DATE 5/7/73

1/273
2/100 2/111

George R. Hardesty, Jr. IS PERMITTED TO INSTALL ALTER

ADDRESS 3221 Erdman Avenue, Baltimore, Md. 21213 PHONE 675-7655

A SEWAGE DISPOSAL SYSTEM LOCATED AT

SUBDIVISION Indian Hills ROAD Howard Lodge Road LOT 37

PROPERTY OWNER Mr. Larry Loftice

ADDRESS 818 Middlesex Road, Baltimore, Md. 21221 (Phone: 391-3614)

SPECIFICATIONS 3 bedrooms

DRAIN FIELD DEPTH FEET, BOTTOM AREA SQ. FT.

SEEPAGE PITS ABSORBENT SIDE-WALL AREA SQ. FT.

SEPTIC TANK CAPACITY 1000 GALLONS

FOR GARBAGE GRINDER, INCREASE DISPOSAL AREA 22% & TANK CAPACITY 50%.

OTHER DRY WELL - 138 sq. ft. absorbent sidewall area per bedroom to begin below the first 2 1/2 ft. of soil. Maximum depth permitted for dry well is 11 ft. below original grade. Locate dry well 36 ft. from left side line and 155 ft. from front ~~front~~ property line as seen from Howard Lodge Road.

NOTE: ALL PIPE FROM HOUSE TO DRY WELL MUST BE CAST IRON.
PERMIT VOID AFTER THREE YEARS.

NOTE: INSTALL STAND PIPE ON SEPTIC TANK AND DRY WELL.


PLANS APPROVED BY Robert V. Torre DATE 9/21/71

FILL SEPTIC TANK AND DISTRIBUTION BOX WITH WATER BEFORE CALLING FOR AN INSPECTION. COVER NO WORK UNTIL INSPECTED AND APPROVED.

NEITHER THE HOWARD COUNTY COMMISSIONERS NOR THE HEALTH DEPARTMENT IS RESPONSIBLE FOR THE SUCCESSFUL OPERATION OF ANY SYSTEM.

A
Loftice

574
 574
 577
 934-2412

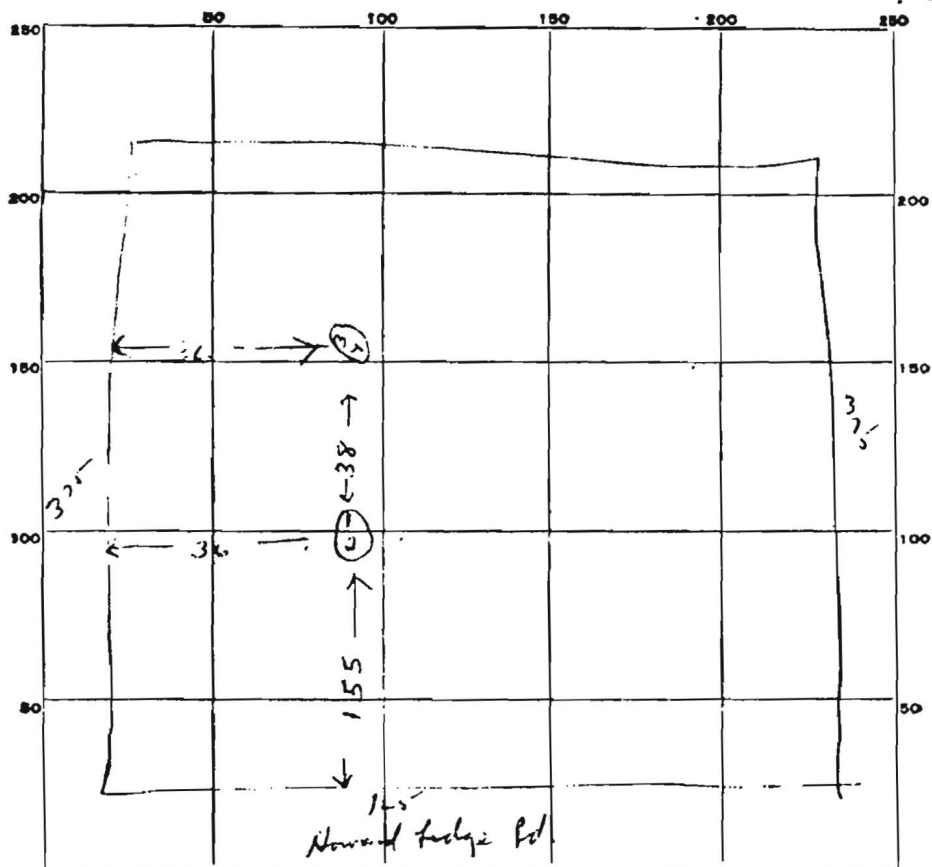

INDICATE NORTH. - NAME ADJOINING ROADWAY AS BASE LINE.

DATE	TEST NO.	DEPTH	PRE-WET		TEST - 1" DROP		TIME
			START	STOP	START	STOP	
4/21	1	13 ft.	9 ⁴³	10 ⁰⁰	10 ⁰⁰	10 ³⁵	35 min
	2	4 ft.	9 ⁴⁷	9 ⁴⁷	9 ⁴⁷	7 ⁵²	5 min
	3	10 1/2 ft.	10 ¹⁶	10 ²⁰	10 ²⁰	10 ²⁹	9 min
	4	3 ft.	10 ¹⁵	10 ¹⁷	10 ¹⁷	10 ²²	5 min
	Good soil to 11 ft. seems to change						

SOIL AUGER FINDING _____

TESTED BY R. Tom

REMARKS _____