

WR-W-4
2-65

State Office Building
ANNAPOLIS, MARYLAND 21401

STATE OF MARYLAND
DEPARTMENT OF
WATER RESOURCES

A-14790

THIS REPORT
MUST BE SUBMITTED
WITHIN 30 DAYS
AFTER COMPLETION
OF THE WELL

Duplan

WELL COMPLETION REPORT

WELL DESCRIPTION

WELL LOG

State the kind of formations penetrated, their color, their depths, their thickness, and if water-bearing

CASING AND SCREEN RECORD

State the kind and size and position of casing, liner, shoe, screen, and other accessories (if no casing used, give diameter of well).

Permit No. HD-6140-57
Owner John A. Duplan
Address 1111 Duplan Rd
Subdivision 1111 Duplan Rd
Section 1111 Duplan Rd Lot 1111 Duplan Rd

PUMPING TEST

Hours Pumped 5
Type of Pump Used Hand
Pumping Rate 70
Gallons per Minute 25

WATER LEVEL

Distance from land surface to water
Before Pumping 5 Ft.
When Pumping 40 Ft.

APPEARANCE OF WATER

Clear Cloudy
Taste _____
Odor _____


Height of Casing Above Land Surface 1.5 Ft.

PUMP INSTALLED

Type _____
Capacity _____
Gallons per Minute _____
Gallons per Hour _____
Pump Column Length _____ Ft.

LOCATION OF WELL ON LOT

Show permanent structures such as buildings, septic tank, and/or other landmarks and indicate not less than 2 distances (measurements) to well.

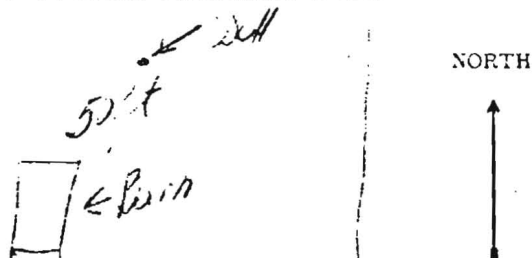

WELL LOG		CASING AND SCREEN RECORD	
FEET from ___ to ___		FEET from ___ to ___	
Top Soil	0-5	Black Steel	6 1/2
Sub H. clay	5-67		0-73
Blue Rock + Flint	67-153	15 Screen	35-
		2 11	135
		0-20 Open Pipe	
		5 Bugz	

well #966

7400 Duplan St