

57
58 below
56 4 11
57 11 11

DATE	TEST NO.	DEPTH	PER-WET		TEST - 1" DROP		TIME	
			START	STOP	START	STOP		
8/15/72	1	5'	9:44	9:47	9:47	9:52	5	
	2	12	9:46	9:51	9:51	9:53	2	
	3	12	10:02	10:04	10:04	10:06	2	
	4	5'	10:04	10:27	little per			
	5	12	10:07	10:13	10:14	10:20	6	
	6	6	10:13	10:14	10:14	10:30	6	
	7	11	TOP 5 FT CLAY BUT 6 FT SAND NO WATER					
8/15/72	8	7	10:37	10:59	10:59	11:20	little per	
	9	4	3:03	3:09	3:07	3:12	5	
	10	4	3:05	3:11	3:11	3:20	4	
	11	4	3:12	3:17	3:13	3:15	2	

SOIL AUGER FINDING

TESTED BY *R. J. Hodson*

REMARKS

41 3:03 3:09 3:07 3:12

R. E. T. M.

APPLICATION

A 21401

SEWAGE DISPOSAL TESTING

STATE OF MARYLAND - DEPARTMENT OF HEALTH AND MENTAL HYGIENE

HOWARD COUNTY HEALTH DEPARTMENT 380 - 1000 gal ST DISTRICT 2nd
ENVIRONMENTAL HEALTH SERVICES 482 - 1250 gal ST DATE 1/24/75
P. O. BOX 476, ELLICOTT CITY, MARYLAND 21043
TELEPHONE: 485-3000, EXT. 398

Trench 90ft long, 3 ft of stone, 11 ft max depth, across top of 4 ft. Run trench between holes A & B, by 4/29, per tests.

TO: THE COUNTY HEALTH OFFICER
ELLICOTT CITY, MARYLAND

I, HEREBY, APPLY FOR THE NECESSARY TEST IN ORDER TO CONSTRUCT (OR RECONSTRUCT) A SEWAGE DISPOSAL SYSTEM.

PROPERTY OWNER David E. Boyd

ADDRESS 2340 Daniels Road, Ellicott City, Md. PHONE _____

PROPERTY LOCATION:

SUBDIVISION _____ LOT NO. _____

ROAD AND DESCRIPTION Daniels Road - 2nd house in on left hand side.

SIZE OF LOT 5.06 acres ± TYPE BLDG. 3 or 4 bedrooms
NUMBER OF BEDROOMS _____

IF NOT SINGLE RESIDENCE DESCRIBE _____

THE SYSTEM INSTALLED UNDER THIS APPLICATION IS ACCEPTABLE ONLY UNTIL PUBLIC FACILITIES BECOME AVAILABLE.

SIGNATURE OF APPLICANT /s/ Olen Lee Ketterman

APPROVED BY *William H. Zepp* FOR DW and for Ketterman DATE 5/1/75
(KIND OF SYSTEM)


REJECTED BY _____ FOR _____ DATE _____
(KIND OF SYSTEM)

HOLD PENDING FURTHER TESTS _____ DATE _____

REASONS FOR REJECTION OR HOLDING _____

THIS IS NOT A PERMIT

A 21401

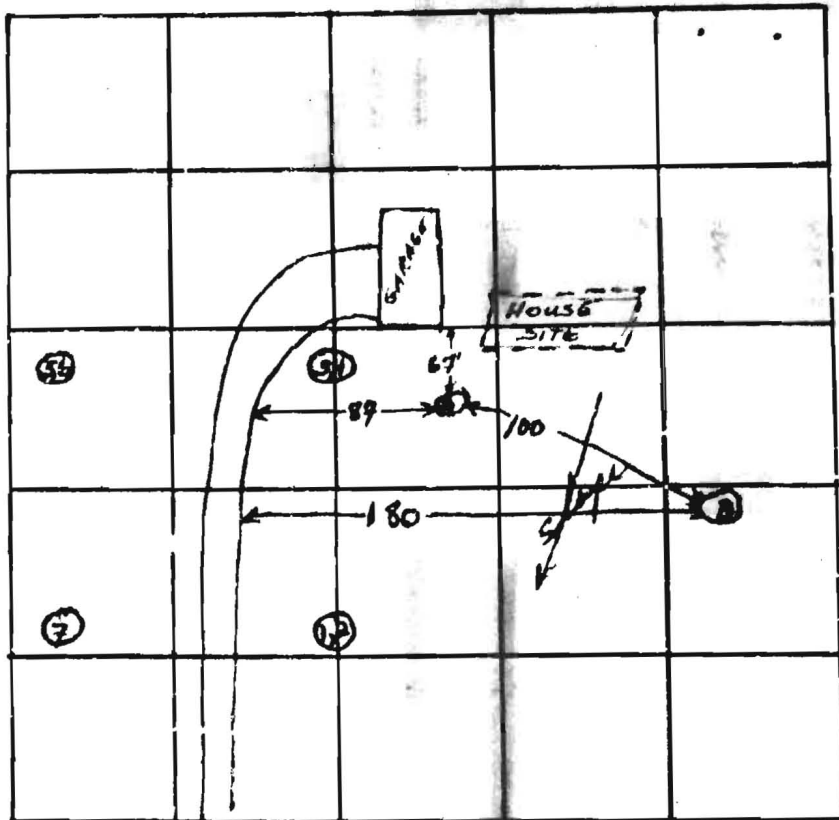

5.06 am
David Boyd

INDICATE NORTH - NAME ADJOINING ROADWAY AS BASE LINE
DANIELS RD

DATE	TEST NO.	DEPTH	PRE-WET		TEST - 1" DROP		TIME
			START	STOP	START	STOP	
4/29/75	A	4	3:03	3:07	3:07	3:12	5
	A-1	12	3:12	3:13	3:13	3:15	2
	B	4	3:05	3:11	3:11	3:20	9
	B-1	12	3:12	3:13	3:13	3:15	2

REMARKS 2 areas to be dug; all test areas still await for repair.
 TYPE OF SOIL Sandy
 TESTED BY WVZ, HJZ ALSO PRESENT: Ketterman, Boyd

