

7/22/75
Approved 10:30 on 11:30 A.M.
ditch inspection

Approved Not Inspected

Permit 7/22/75 R.F.

PERMIT

SEWAGE DISPOSAL SYSTEM

MARYLAND STATE DEPARTMENT OF HEALTH

HOWARD COUNTY

ELLICOTT CITY

DISTRICT 2nd

DATE 7/22/75

P 21866
A 21809
See P1678 also

INDEXED

Olan Ketterman

IS PERMITTED TO INSTALL X ALTER

ADDRESS 6119 Jerry's Drive, Columbia, Md. 21044

PHONE 997-8789

A SEWAGE DISPOSAL SYSTEM LOCATED AT _____

SUBDIVISION _____

ROAD 2538 Daniels Road

LOT _____

PROPERTY OWNER David E. Boyd

ADDRESS 2940 Daniels Road, Ellicott City, Maryland

SPECIFICATIONS 3 bedrooms

DRAIN FIELD _____ DEPTH _____ FEET. BOTTOM AREA _____ SQ. FT.

SEEPAGE PITS _____ ABSORBENT SIDE-WALL AREA _____ SQ. FT.

SEPTIC TANK CAPACITY 1000 GALLONS

FOR GARBAGE GRINDER, INCREASE DISPOSAL AREA 22% & TANK CAPACITY 50%.

OTHER: TRENCH - 70 ft. long, 7 ft. of stone, 11 ft. maximum depth, slost to top 4 ft. or ground. Run trench between holes & E.H. of April 29, 1975 per test. Call for inspection of trench before gravel is installed.

NOTE: ALL PIPE FROM HOUSE TO DISPOSAL AREA MUST BE CAST IRON.

PERMIT VOID AFTER THREE YEARS.

NOTE: INSTALL STAND PIPE ON SEPTIC TANK. STAND PIPES MUST BE 6 INCHES IN DIAMETER. CAST IRON, CONCRETE OR THERM COLOY ACCEPTED.

PLANS APPROVED BY William W. Zepp

DATE 5/1/75

FILL SEPTIC TANK AND DISTRIBUTION BOX WITH WATER BEFORE CALLING FOR AN INSPECTION. COVER NO WORK UNTIL INSPECTED AND APPROVED.


NEITHER THE HOWARD COUNTY COMMISSIONERS NOR THE HEALTH DEPARTMENT IS RESPONSIBLE FOR THE SUCCESSFUL OPERATION OF ANY SYSTEM.

pool permit
41956 signed
4/19/79

BLDG. PERMIT SIGNED
AND RETURNED 7/31/75 Septic OK

See F-82-130

ALL

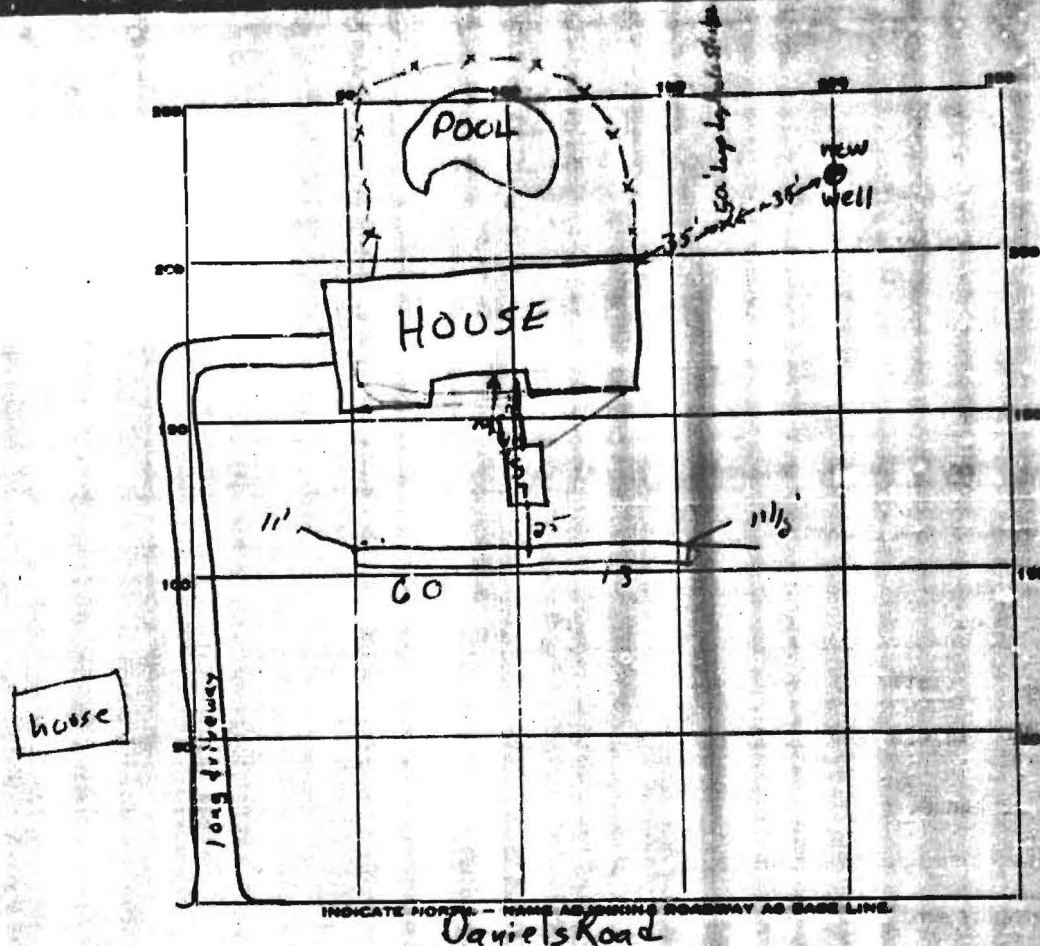

PERMIT CARD OK

SEPTIC TANK, LEVEL OK CLEANOUTS OK

DISTRIBUTION BOX, LEVEL _____

TILE FIELD, DEPTH 11 FT. TRENCH WIDTH 2 FT.

GRAVEL DEPTH _____ IN. TOTAL LENGTH 73 FT.

NUMBER OF TRENCHES 1 TOTAL BOTTOM AREA 146

SEEPAGE PITS, INSIDE DIAMETER _____ FT. DEPTH BELOW INLET _____ FT.

ABSORBENT AREA _____ SQ. FT.

REMARKS 7-23-75 - OK for gravel install.

System on being put in before house built. will have to see connection from house to tank before D.O. can be signed out.
 Saw stone on hill side of tank gave OK to complete R.T.
 7/23/75 - System completed - OK to build - distribution given
 to call when system is complete

DATE SYSTEM APPROVED 2/23/75 INSPECTOR D. J. [Signature]