

RECORDED

APPLICATION

A 10220

SEWAGE DISPOSAL TESTING

P _____

MARYLAND STATE DEPARTMENT OF HEALTH

HOWARD COUNTY

ELLICOTT CITY

Septic tank - 750 gal.

DISTRICT 7

*Drywell - 324 sq. ft. absorbent
sidewall area below inlet pipe.
Locate drywell 96 ft. from front lot line and
16 ft. from right side line as lot is seen
when facing it from D.R. 144.*

DATE 2/12/55

TO: THE COUNTY HEALTH OFFICER
ELLICOTT CITY, MARYLAND

*of Drywell is 156 ft from front line and
16 from right side line system should be 424 sq
ft absorbent sidewall area below inlet pipe*

I, HEREBY, APPLY FOR THE NECESSARY TESTS IN ORDER TO CONSTRUCT (OR RECONSTRUCT) A SEWAGE DISPOSAL SYSTEM.

PROPERTY OWNER Mr. & Mrs. W. J. Smith

ADDRESS 312 North 1st St., Ellicott City, Md. PHONE _____

PROPERTY LOCATION:

SUBDIVISION _____ LOT NO. _____

ROAD AND DESCRIPTION St. Albans (East part of town) - lot 1 on left side of St. Albans

OCCUPANT _____ PHONE _____

PERSON TO CONSTRUCT SYSTEM _____

ADDRESS _____ PHONE _____

SIZE OF LOT _____ TYPE BLDG. _____ NUMBER OF BEDROOMS _____

IF NOT SINGLE RESIDENCE DESCRIBE _____

SIGNATURE OF APPLICANT *W. J. Smith*


APPROVED BY _____ FOR _____ (KIND OF SYSTEM) DATE _____

REJECTED BY _____ FOR _____ (KIND OF SYSTEM) DATE _____

HOLD PENDING FURTHER TESTS _____ DATE _____

REASONS FOR REJECTION OR HOLDING _____

THIS IS NOT A PERMIT

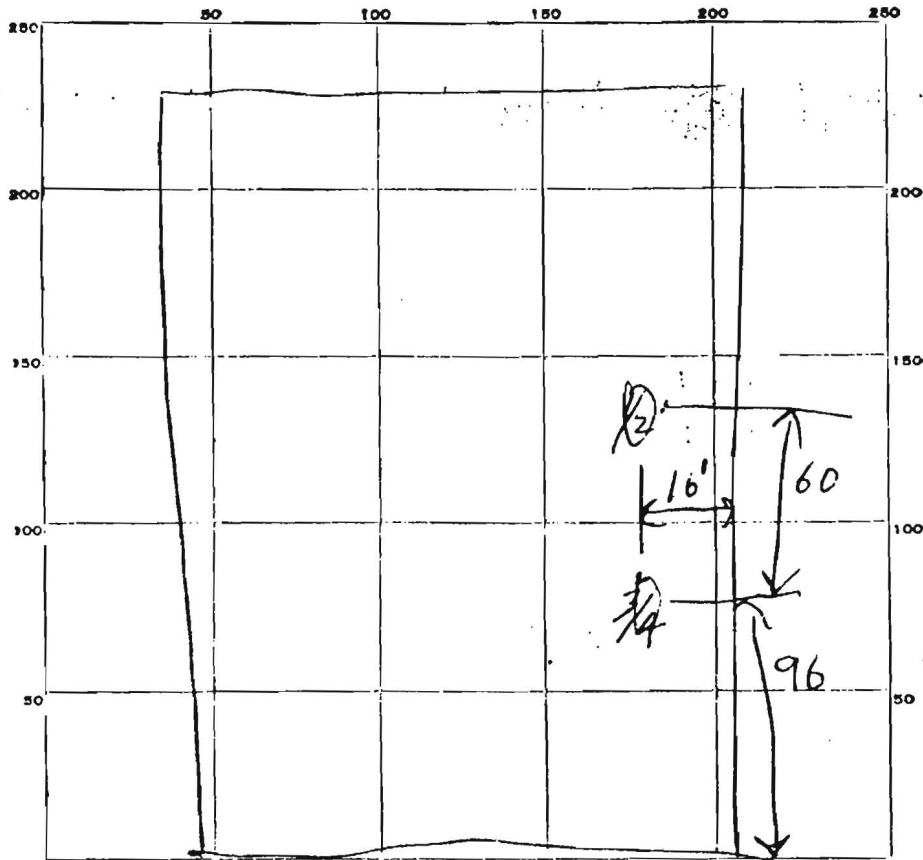

INDICATE NORTH. - NAME ADJOINING ROADWAY AS BASE LINE.

Rt. 144 E ← → W

DATE	TEST NO.	DEPTH	PRE-WET		TEST - 1" DROP		TIME
			START	STOP	START	STOP	
9/21/65	1	10 ft.	1:19	1:25	1:25	1:36	11 min.
	2	5 ft.	1:21	1:31	1:31	1:51	20 min.
	3	10 ft.	1:26	1:28	1:28	1:31	3 min.
	4	5 ft.	1:27	1:29	1:29	1:31	2 min.

4
136
36

gmin
Avg

SOIL AUGER FINDING _____

TESTED BY RDE 9/21/65

REMARKS _____