

Miss After 12

PERMIT

SEWAGE DISPOSAL SYSTEM

P 11334

A 10928

MARYLAND STATE DEPARTMENT OF HEALTH

HOWARD COUNTY

ELLCOTT CITY

INDEXED

DISTRICT 3

DATE 12/8/65

Frank J. Klein & Sons IS PERMITTED TO INSTALL X ALTER

ADDRESS 300 Reisterstown Rd., Reisterstown, Md. PHONE HI 6-6500

A SEWAGE DISPOSAL SYSTEM LOCATED AT _____

SUBDIVISION _____ ROAD Rt. 144 - just beyond LOT

Triadelphia Rd. on left

PROPERTY OWNER Wm. Buell & wife

ADDRESS _____

SPECIFICATIONS - 3 bedrooms

DRAIN FIELD _____ DEPTH _____ FEET, BOTTOM AREA _____ SQ. FT.

SEEPAGE PITS _____ ABSORBENT SIDE-WALL AREA _____ SQ. FT.

SEPTIC TANK CAPACITY 750 GALLONS

FOR GARBAGE GRINDER, INCREASE DISPOSAL AREA 22% & TANK CAPACITY 50%.

OTHER Dry well - 324 sq. ft. absorbent sidewall area below inlet pipe.

15' from front of house
Locate dry well 96 ft. from front lot line and 16 ft. from right side line as

lot is seen when facing it from Rt. 144. If dry well is 156 ft. from front

line and 16 ft. from right sideline system should be 424 sq. ft. absorbent

side wall area below inlet pipe.

PLANS APPROVED BY R. Fletcher DATE 9/21/65

FILL SEPTIC TANK AND DISTRIBUTION BOX WITH WATER BEFORE CALLING FOR AN INSPECTION. COVER NO WORK UNTIL INSPECTED AND APPROVED.


NEITHER THE HOWARD COUNTY COMMISSIONERS NOR THE HEALTH DEPARTMENT IS RESPONSIBLE FOR THE SUCCESSFUL OPERATION OF ANY SYSTEM.

Not to be used to replace...

AND RETURNED 12/10/65
Health Dept
FOR DEPARTMENT USE
10-005-002

A 10928

Well-?

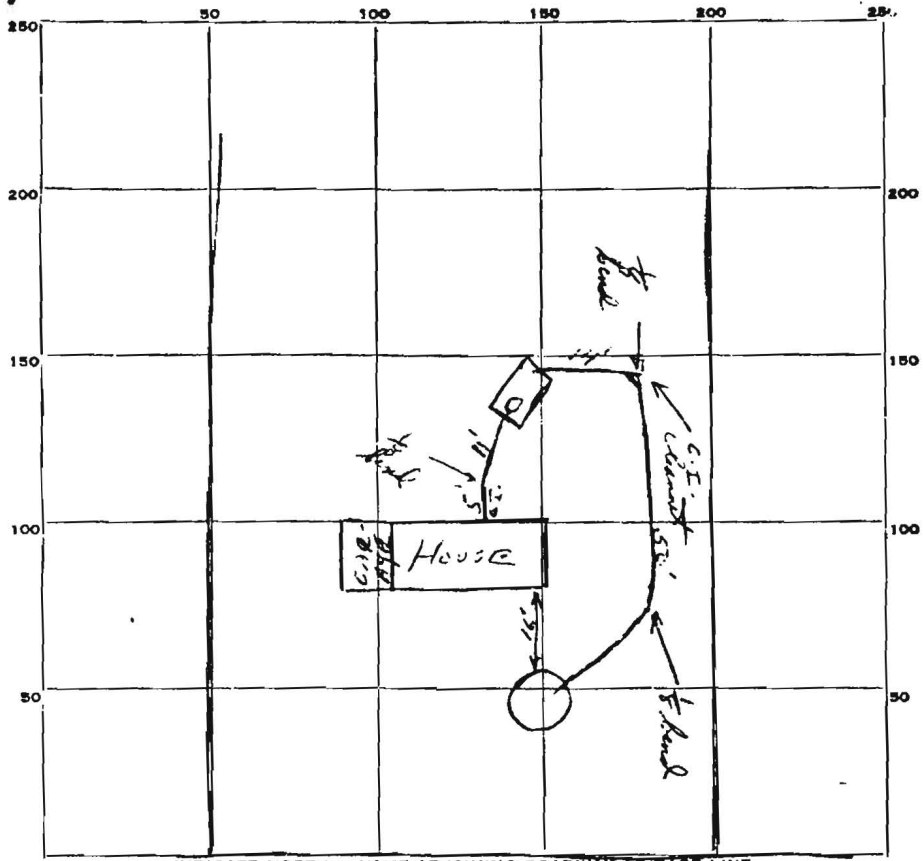

INDICATE NORTH. - NAME ADJOINING ROADWAY AS BASE LINE.

RT 144

PERMIT CARD 1/22

SEPTIC TANK, LEVEL concrete 1000 gal.

CLEANOUTS 6" stand pipe

DISTRIBUTION BOX, LEVEL _____

TILE FIELD, DEPTH _____ FT. TRENCH WIDTH _____ FT.

GRAVEL DEPTH _____ IN. TOTAL LENGTH _____ FT.

NUMBER OF TRENCHES _____ TOTAL BOTTOM AREA _____

SEEPAGE PITS, INSIDE DIAMETER 14 FT. DEPTH BELOW INLET 10 1/2 FT.

ABSORBENT AREA OK SQ. FT.

Bottom - ?
Invert - ? 4

REMARKS _____

DATE SYSTEM APPROVED 12-15-65

INSPECTOR J. Hennigan