

10/16/89/11 AM

Need C.O. on Dry Wells P.C.O.C.P.C. only

PERMIT

SEWAGE DISPOSAL SYSTEM

MARYLAND STATE DEPARTMENT OF HEALTH

DISTRICT _____

HOWARD COUNTY

BUREAU OF ENVIRONMENTAL HEALTH
461-9933

INDEXED

NO FURTHER
AS OF 8/21/95
- INDEX (circled)

P 44891
A REPAIR

DATE 8/23/89

DATE SYSTEM APPROVED 10/16/89
INSPECTED, NOT APPROVED
INSPECTOR CBS

C. C. Cissel IS PERMITTED TO INSTALL _____ ALTER

ADDRESS 14079 Brighton Dam Road, Clarksville, Maryland PHONE 854-2006

SUBDIVISION _____ ROAD 6836 Mink Hollow Road LOT C. C. CISSEL

PROPERTY OWNER PRESENT Jill and Stanley Oleinik } LILLY, FLOYD

FOR → 6836 Mink Hollow Road } { DARREN LILLY }

ADDRESS Highland, Maryland 20777 } FUTURE OWNER

IF GARBAGE GRINDER IS USED INCREASE SEPTIC TANK CAPACITY BY 50% AND ABSORPTION AREA BY 22%.

GARBAGE GRINDER? YES NO _____

SEPTIC TANK CAPACITY 1200 GALLONS NUMBER OF BEDROOMS 4

REPAIR - CALL FOR INSPECTION WHEN GROUND IS OPENED SO SANITARIAN CAN RECOMMEND REPAIR.

PLANS APPROVED BY C. Williams DATE 8/23/89


- COVER NO WORK UNTIL INSPECTED AND APPROVED
- NEITHER THE HOWARD COUNTY COUNCIL NOR THE HEALTH DEPARTMENT IS RESPONSIBLE FOR THE SUCCESSFUL OPERATION OF ANY SYSTEM
- NOTE: CLEANOUT REQUIRED EVERY 70 FEET OF SEWER LINE AND/OR AT 90° SWEEPS IN LINES FROM HOUSE TO DRAIN FIELDS
- NOTE: ALL PARTS OF SEPTIC SYSTEMS (I.E., TANK, DISTRIBUTION BOX, TRENCHES) TO BE 100 FEET FROM WELL (UNLESS OTHERWISE SPECIFICALLY AUTHORIZED)
- NOTE: IF DEEP TRENCHES ARE USED CALL FOR INSPECTION BEFORE AND AFTER PLACING GRAVEL IN TRENCHES
- NOTE: NO DRY WELL SHALL EXCEED 15 FOOT IN DIAMETER NO ABSORPTION TRENCH TO EXCEED 100 FEET IN LENGTH.
- NOTE: ALL PIPE FROM HOUSE TO SEPTIC TANK MUST BE CAST IRON OR SCHEDULE 40 PVC OR ABS
- PERMIT VOID AFTER TWO YEARS
- NOTE: INSTALL STAND PIPE ON SEPTIC TANK AND DRY WELL. STAND PIPES MUST BE 6 INCHES IN DIAMETER. CAST IRON, CONCRETE OR TERRA COTTA OR PVC OR ABS ACCEPTED. IF TOP OF SEPTIC TANK IS DEEPER THAN 3 FEET, MANHOLE TO GRADE REQUIRED
- NOTE: DISTRIBUTION BOXES MUST HAVE BAFFLES

***INSTALLER IS RESPONSIBLE FOR OBTAINING FINAL APPROVAL ON THIS PERMIT**

*CALL 461-9933 FOR INSPECTION OF SEPTIC SYSTEMS.

P44891

A 15800

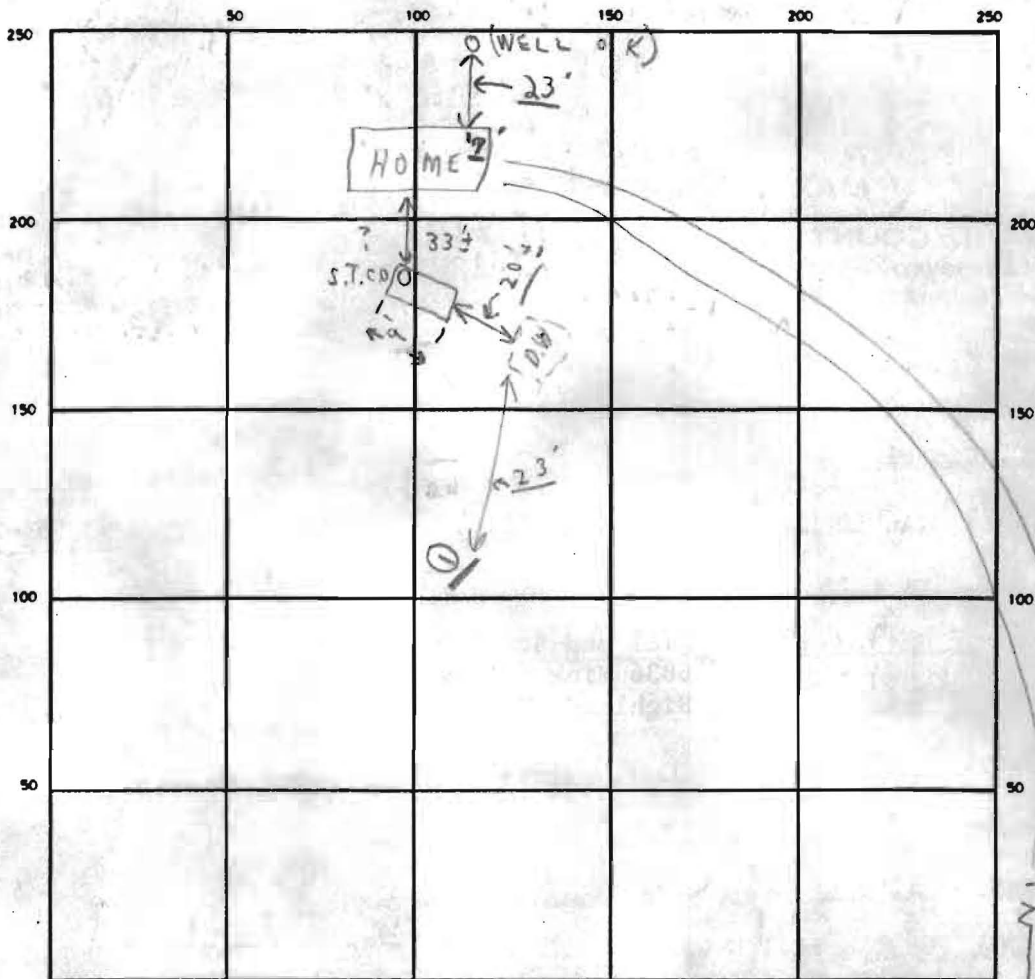

① Visual -
 Deep 13'-10"
 (3' - 13'-10")
 LOAM 95%
 + 5%
 (Mudstone)

INDICATE NORTH — NAME ADJOINING ROADWAY AS BASE LINE

← MINK HOLLOW ROAD
 D.W.

SEPTIC TANK. LEVEL _____ CLEANOUTS _____ (Needs C.O. only)

DISTRIBUTION BOX. LEVEL _____

DRAIN FIELD/TILE FIELD. DEPTH _____ FT. TRENCH WIDTH 2 FT. INLET DEPTH _____ FT.

EFFECTIVE GRAVEL DEPTH _____ FT. TOTAL LENGTH _____ FT.

NUMBER OF TRENCHES _____ ONE SIDEWALL/BOTTOM AREA _____ SQ. FT.

DRYWELL INSIDE DIAMETER _____ FT. EFFECTIVE DEPTH BELOW INLET _____ FT.

ABSORBENT AREA _____ SQ. FT.

REMARKS 10/16/89 Repair - located a S.T. + D.W.;
Exits → D.W. ^{concretely} 3 1/2' - 4' inlet (?) on side; S.T. 3 1/2' below
ground with clean out + large ^{concretely} tank 1200(?)' x 1200'
9' ± Long; 1 Visual hole ok; Pasted need dry well
clean out to grade only at this time.
 J.C.B.

DATE SYSTEM APPROVED _____ INSPECTOR _____