

APPLICATION

A 19628

SEWAGE DISPOSAL TESTING

P _____

STATE OF MARYLAND - DEPARTMENT OF HEALTH AND MENTAL HYGIENE
HOWARD COUNTY HEALTH DEPARTMENT
ENVIRONMENTAL HEALTH SERVICES
P. O. BOX 476, ELLICOTT CITY, MARYLAND 21043
TELEPHONE: 465-8000, EXT. 386

Septic Tank - 1500 gal

DISTRICT 5

Dry Well - 300 gal

DATE 6/27/73

absent, sidewalk area to begin below the inlet. Maximum depth permitted for drywell is 12 ft. below original grade. Single dry well 175 ft from right side lane and 370 ft from front lot line as seen from Haviland Mill Rd.

TO: THE COUNTY HEALTH OFFICER
ELLICOTT CITY, MARYLAND

I, HEREBY, APPLY FOR THE NECESSARY TEST IN ORDER TO CONSTRUCT (OR RECONSTRUCT) A SEWAGE DISPOSAL SYSTEM.

PROPERTY OWNER ROBERT A. SCHREMP

ADDRESS 6883 HAVILANDS MILL RD. PHONE 774-9572
CLARKSVILLE, MD.

PROPERTY LOCATION:

SUBDIVISION _____ LOT NO. _____

ROAD AND DESCRIPTION LOT IS LOCATED AT ABOVE ADDRESS WHICH IS

APPROX. 1 MILE FROM WHERE BRICKTON DAM RD. MEETS HAVILANDS
MILL RD. THE ABOVE ADDRESS IS A LARGE WHITE HOUSE WITH BLACK SHUTTERS
WITH WHITE BOARD FENCE IN FRONT

SIZE OF LOT 9 ACRES TYPE BLDG. 3 BEDROOM

IF NOT SINGLE RESIDENCE DESCRIBE _____

NUMBER OF BEDROOMS
RESIDENCE
SINGLE DWELLING

THE SYSTEM INSTALLED UNDER THIS APPLICATION IS ACCEPTABLE ONLY UNTIL PUBLIC FACILITIES BECOME AVAILABLE.

SIGNATURE OF APPLICANT Robert A. Schrempp

APPROVED BY Robert V. Lane FOR Dry Well DATE 11/2/73

REJECTED BY _____ FOR _____ DATE _____



HOLD PENDING FURTHER TESTS _____ DATE _____

REASONS FOR REJECTION OR HOLDING _____

Tested in different Area

THIS IS NOT A PERMIT

filed A 20418

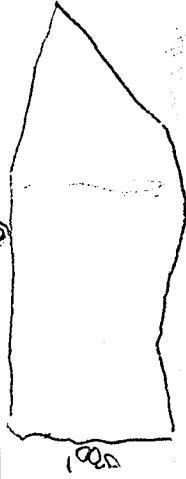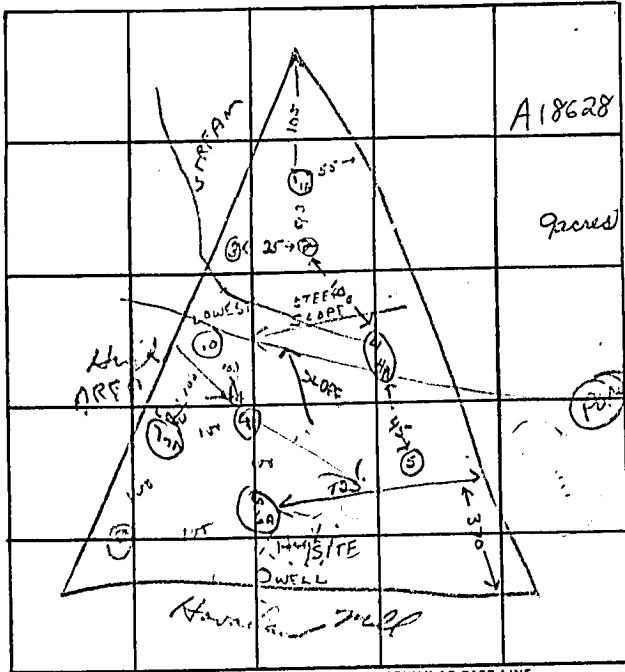

INDICATE NORTH - NAME ADJOINING ROADWAY AS BASE LINE.

DATE	TEST NO.	DEPTH	PRE-WET		TEST - 1" DROP		TIME	
			START	STOP	START	STOP		
9/23/23	1	11 1/2 ft	11 55	11 59	11 59	12 06	7 min in pre-wet tunnel	
	1A	3 1/2 ft	11 40			11 43	3 min	
	2	10 1/2	10 1/2	Evaporation - level soil up to this point				
	3	9 1/2	Water stabilized at this point					
	4	3	12 12			12 15	3 min	
	4A	12 ft	12 16	12 18	12 18	12 22	4 min	
	5	6 ft	Water					
11/21/24	6	4 1/2 ft	15 53	15 53	15 53	16 01	4 min	
	6A	12 ft	15 57	15 57	15 57	16 07	4 min	
	7	11 1/2 ft	2 05	2 10	2 10	2 15	3 min	
	7A	4 1/2 ft	2 08	2 10	2 10	2 14	4 min	
	8	11 ft						

REMARKS 7 holes R. Tower - Holes were very sandy.

TYPE OF SOIL Holes to show 10 - level soil and shale
 9/30/24 Hole (10) dug to 10 1/2 ft - letting 11 1/2 ft
 Shale was 3 ft. Well over 10,000 ft. Outlet at any depth.