

3151

SEQUENCE NO (OEP USE ONLY)

STATE OF MARYLAND WELL COMPLETION REPORT

THIS REPORT MUST BE SUBMITTED WITHIN 45 DAYS AFTER WELL IS COMPLETED.

(THIS NUMBER IS TO BE PUNCHED IN COLUMNS 2-6 ON ALL CARDS)

COUNTY NUMBER 421401

Date Received (OEP use only)

DATE WELL COMPLETED 5-8-52

W. TONG add.

Depth of Well 100'

PERMIT NO. FROM PERMIT TO DRILL WELL 14-7-42

OWNER Boyd

NAME Daniel

STREET OR RFD 2338 Daniels Road

TOWN Hicott City

SUBDIVISION

SECTION

LOT

STATE THE KIND OF FORMATIONS PENETRATED, THEIR COLOR, DEPTH, THICKNESS AND IF WATER BEARING

DESCRIPTION (use additional sheets if needed)	FEET		Color of water (nearest)
	FROM	TO	
OVERBURDEN	0	10	
BROWN SLATE	10	48	
GRAY ROCK	48	100 X	

Well #1 500' deep (BACKFILLED)

WELL HAS BEEN DRILLED (Circle Appropriate Box)

TYPE OF GRINDING MATERIAL CEMENT (C) BENTONITE CLAY (B)

NO. OF BAGS 13 NO. OF POUNDS 330

GALLONS OF WATER DEPTH OF ABOUT SEAL (to nearest foot) from 8 ft. to 24 ft.

CASING RECORD (circle type) STEEL (S), CONCRETE (C), PLASTIC (P), OTHER (O)

MAIN CASING TYPE Normal diameter (nearest inch) 6 Total depth of main casing (nearest foot) 50

OTHER CASING (circle type) diameter length depth-foot

SCREEN RECORD (circle type) STEEL (S), BRASS (B), OPEN HOLE (O), PLASTIC (P), OTHER (O)

DEPTH (nearest ft.) 40, 50, 100

SLOT SIZE DIAMETER OF SCREEN (NEAREST INCH) from 10 to 20

GRAVEL PACK IF WELL DRILLED WAS FLOWING WELL (circle box) F

OEP USE ONLY (NOT TO BE FILLED IN BY DRILLER) TELESCOPE CASING (T), LOG INDICATOR (L), OTHER DATA (O)

HOURS PUMPED (nearest hour) 3

PUMPING RATE (gal. per min. to nearest gal.) 10.0

METHOD USED TO MEASURE PUMPING RATE AIR

WATER LEVEL (distance from land surface) BEFORE PUMPING 370

WHEN PUMPING 680

TYPE OF PUMP USED (circle) A, P, T, C, R, J, S

DRILLER WILL INSTALL PUMP (circle appropriate box) Y, N

IF DRILLER INSTALLS PUMP, THIS SECTION MUST BE COMPLETED FOR ALL WELLS EXCEPT HOME USE

TYPE OF PUMP (WRITE APPROPRIATE LETTER IN BOX - SEE ABOVE) S


CAPACITY: GALLONS PER MINUTE (to nearest gallon) 5

PUMP HORSE POWER 1/3

PUMP COLUMN LENGTH (nearest ft.) 70

CASING HEIGHT (circle appropriate box) + above, - below

LOCATION OF WELL ON LOT SHOW PERMANENT STRUCTURE SUCH AS BUILDING, SEPTIC TANKS, AND/OR LANDMARKS AND INDICATE NOT LESS THAN TWO DISTANCES (IN MEASUREMENTS TO WELL)

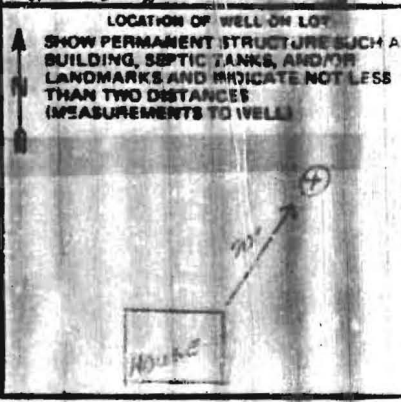

- (A) A WELL WAS ABANDONED AND SEALED WHEN THIS WELL WAS COMPLETED
- (E) ELECTRIC LOG OBTAINED
- (P) TEST WELL CONVERTED TO PRODUCTION WELL

I HEREBY CERTIFY THAT THIS WELL HAS BEEN CONSTRUCTED IN ACCORDANCE WITH COMAR 10.17.13

DRILLERS IDENT NO 120

DRILLERS SIGNATURE (MUST MATCH SIGNATURE ON APPLICATION) Thomas M. Coates

SITE SUPERVISOR (sign of driller or journeyman responsible for signwork if different from permittee)