

file approved 11/7/74
P 20888
A 20418

PERMIT

SEWAGE DISPOSAL SYSTEM

MARYLAND STATE DEPARTMENT OF HEALTH

HOWARD COUNTY

ELLICOTT CITY

DISTRICT 5th

DATE 11/4/74

11/7/74
After 11:00 A.M.
will be ready

INDEXED

Christopher R. Spengler

IS PERMITTED TO INSTALL ALTER

ADDRESS 8928-F Town and Country Blvd., Ellicott City, Md. PHONE 465-9217 or 286-2406

A SEWAGE DISPOSAL SYSTEM LOCATED AT

SUBDIVISION orig house 6883 H.M. Rd.
in lot from Ruffin Down Rd. ROAD 6891 Haviland Mill Road LOT

PROPERTY OWNER Robert A. Schremp

ADDRESS 6883 Haviland Mill Road, Clarksville, Md. Phone: 774-9572

SPECIFICATIONS 3 bedrooms - Garbage grinder will increase system.

DRAIN FIELD DEPTH FEET, BOTTOM AREA SQ. FT.

SEEPAGE PITS ABSORBENT SIDE-WALL AREA SQ. FT.

SEPTIC TANK CAPACITY 1000 GALLONS

FOR GARBAGE GRINDER, INCREASE DISPOSAL AREA 22% & TANK CAPACITY 50%.

OTHER DRY WELL - 300 sq. ft. ~~absorbent~~ absorbent sidewall area to begin below the inlet. Inlet to be 3 1/4 ft. Maximum depth is 12 ft. Locate dry well 100 ft. from well (already installed). Dry well to be placed on highest side of lot.

NOTE: ALL PIPE FROM HOUSE TO DISPOSAL AREA MUST BE CAST IRON.

PERMIT VOID AFTER THREE YEARS.

NOTE: INSTALL STAND PIPE ON SEPTIC TANK AND DRY WELL. STAND PIPES MUST BE 6 INCHES - CAST IRON, CONCRETE OR TERRA COTTA ACCEPTED.

PLANS APPROVED BY Robert V. Torre DATE 7/31/74


FILL SEPTIC TANK AND DISTRIBUTION BOX WITH WATER BEFORE CALLING FOR AN INSPECTION. COVER NO WORK UNTIL INSPECTED AND APPROVED.

NEITHER THE HOWARD COUNTY COMMISSIONERS NOR THE HEALTH DEPARTMENT IS RESPONSIBLE FOR THE SUCCESSFUL OPERATION OF ANY SYSTEM.

BLDG. PERMIT SIGNED AND RETURNED 7/29/74
Serial #71428
Additional Bedroom
Back - 2 car garage.

A 20418

20418

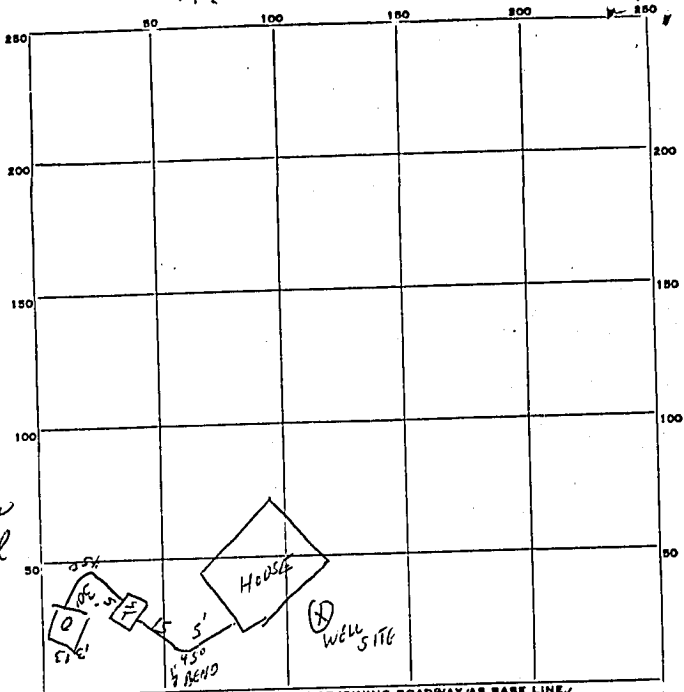

Location
100' from
well

INDICATE NORTH - NAME ADJOINING ROADWAY AS BASE LINE
Hawlland Mill Rd

PERMIT CARD _____

SEPTIC TANK, LEVEL DK 1500 galls CLEANOUTS OK

DISTRIBUTION BOX, LEVEL N/A

TILE FIELD, DEPTH N/A FT. TRENCH WIDTH N/A FT.

GRAVEL DEPTH N/A IN. TOTAL LENGTH N/A FT.

NUMBER OF TRENCHES 0 TOTAL BOTTOM AREA _____

SEEPAGE PITS, ~~INSIDE~~ ^{OUTSIDE} 57 1/2 FT. DEPTH BELOW INLET 7 1/2 FT.

ABSORBENT AREA 290 SQ. FT.

REMARKS Good job. System measured for
garbage grinder.

DATE SYSTEM APPROVED 11/7/74 INSPECTOR H. J. WBAR