

8/1/66

INDEXED

# PERMIT

SEWAGE DISPOSAL SYSTEM

P. 11901

A. 07216

MARYLAND STATE DEPARTMENT OF HEALTH

HOWARD COUNTY

ELLICOTT CITY

DISTRICT 1

DATE 8/1/66

~~Wood Seeps~~ IS PERMITTED TO INSTALL  ALTER

ADDRESS Murphy Rd., Laurel, Md. PHONE PA 5-2224

A SEWAGE DISPOSAL SYSTEM LOCATED AT \_\_\_\_\_

SUBDIVISION \_\_\_\_\_  
ROAD 2480 Thompson Dr. LOT \_\_\_\_\_

PROPERTY OWNER Katherine Dorsey

ADDRESS \_\_\_\_\_

SPECIFICATIONS - 3 bedrooms

DRAIN FIELD \_\_\_\_\_ DEPTH \_\_\_\_\_ FEET, BOTTOM AREA \_\_\_\_\_ SQ. FT.

SEEPAGE PITS \_\_\_\_\_ ABSORBENT SIDE-WALL AREA \_\_\_\_\_ SQ. FT.

SEPTIC TANK CAPACITY 750 GALLONS

FOR GARBAGE GRINDER, INCREASE DISPOSAL AREA 25% & TANK CAPACITY 50%.

OTHER ~~510 sq. ft. - 470 sq. ft. bottom area of~~

~~Leaching Bed - 600 sq. ft. bottom area installed with bottom of bed to grade 4 ft. to 6 ft.~~

~~Place the underground drainage system in the area 10 ft. to 50 ft. from the left side of the lot as seen when facing the lot from Thompson Drive and 70 ft. to 160 ft. from the front lot line.~~

NOTE: ~~CALL FOR INSPECTION OF LEACHING BED EXCAVATION BEFORE ANY GRAVE IS INSTALLED.~~


PLANS APPROVED BY Raymond Hedges DATE 8/15/63

FILL SEPTIC TANK AND DISTRIBUTION BOX WITH WATER BEFORE CALLING FOR AN INSPECTION. COVER NO WORK UNTIL INSPECTED AND APPROVED.

NEITHER THE HOWARD COUNTY COMMISSIONERS NOR THE HEALTH DEPARTMENT IS RESPONSIBLE FOR THE SUCCESSFUL OPERATION OF ANY SYSTEM.

58574-B  
A 61270

576  
156

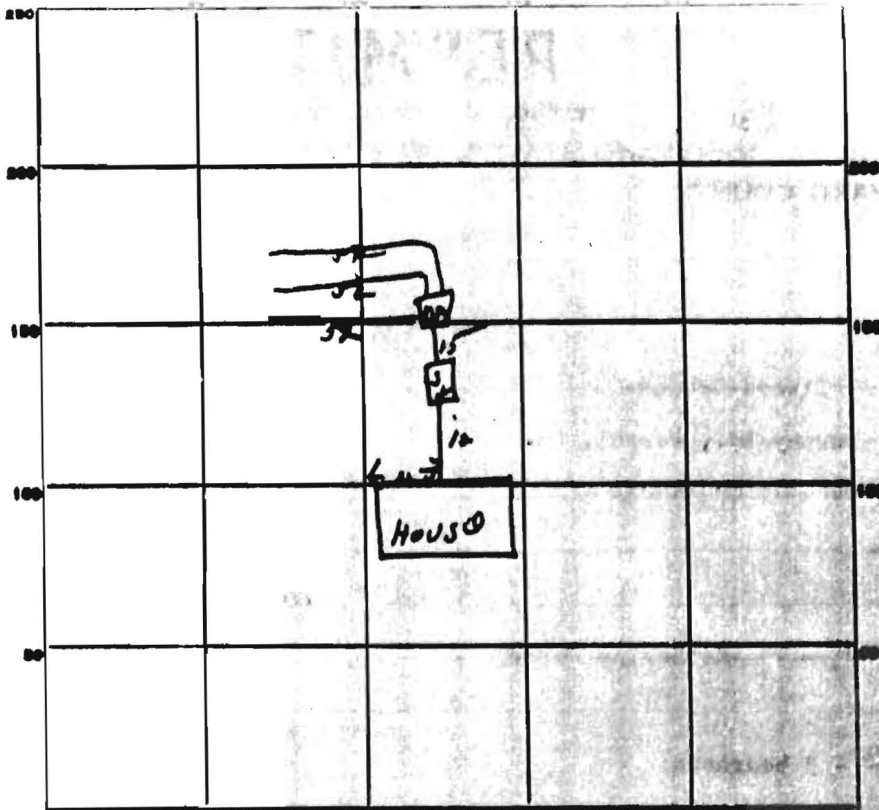

INDICATE NORTH - NAME ADJOINING ROADWAY AS BASE LINE.

*Thompson Run*

PERMIT CARD OK

SEPTIC TANK, LEVEL OK

CLEANOUTS OC

DISTRIBUTION BOX, LEVEL OK

TILE FIELD, DEPTH 3-4 FT. TRENCH WIDTH 3 FT.

GRAVEL DEPTH 12 IN. TOTAL LENGTH 156 FT.

NUMBER OF TRENCHES 3 TOTAL BOTTOM AREA 468

SEEPAGE PITS, INSIDE DIAMETER \_\_\_\_\_ FT. DEPTH BELOW INLET \_\_\_\_\_ FT.

ABSORBENT AREA \_\_\_\_\_ SQ. FT.

REMARKS \_\_\_\_\_

DATE SYSTEM APPROVED 8-1-66

INSPECTOR DuManay