

app - 10/11/68
DLS 700

PERMIT

P 13968

A 09003

SEWAGE DISPOSAL SYSTEM

MARYLAND STATE DEPARTMENT OF HEALTH

HOWARD COUNTY

ELLICOTT CITY

DISTRICT 3

DATE 9/25/68

INDEXED

Sub. 40 & USF 14

ASTM D-2661-74
266574 PVC

10/11/68
Ready

Jack Fyock IS PERMITTED TO INSTALL ALTER

ADDRESS Ten Oaks Road, Dayton, Maryland PHONE

A SEWAGE DISPOSAL-SYSTEM LOCATED AT

SUBDIVISION Burnt Wood ROAD Castlebar Drive LOT 7, Blk. B, Sec. 3, Pt. 1

PROPERTY OWNER Burnt Woods Development Co., Inc.

ADDRESS

SPECIFICATIONS - 4 bedrooms

DRAIN FIELD DEPTH FEET, BOTTOM AREA SQ. FT.

SEEPAGE PITS ABSORBENT SIDE-WALL AREA SQ. FT.

SEPTIC TANK CAPACITY 1,000 GALLONS

FOR GARBAGE GRINDER, INCREASE DISPOSAL AREA 22% & TANK CAPACITY 50%.

OTHER Dry well - 143 sq. ft. absorbent sidewall area below inlet per bedroom.

Locate dry well 40 ft. from front lot line and 73 ft. from right side line as

lot is seen when facing it from Street "B" - Castlebar Drive.

Inlet pipe no deeper than 3 ft. below original grade. Max. depth permitted 12 ft.

PERMIT VOID AFTER THREE YEARS.


PLANS APPROVED BY Monaghan-Fletcher DATE 9/28/64

FILL SEPTIC TANK AND DISTRIBUTION BOX WITH WATER BEFORE CALLING FOR AN INSPECTION. COVER NO WORK UNTIL INSPECTED AND APPROVED.

NEITHER THE HOWARD COUNTY COMMISSIONERS NOR THE HEALTH DEPARTMENT IS RESPONSIBLE FOR THE SUCCESSFUL OPERATION OF ANY SYSTEM.

NOTIFY THE HEALTH DEPARTMENT 48 HOURS BEFORE EXCAVATIONS ARE TO BE BACK FILLED.

A 09003

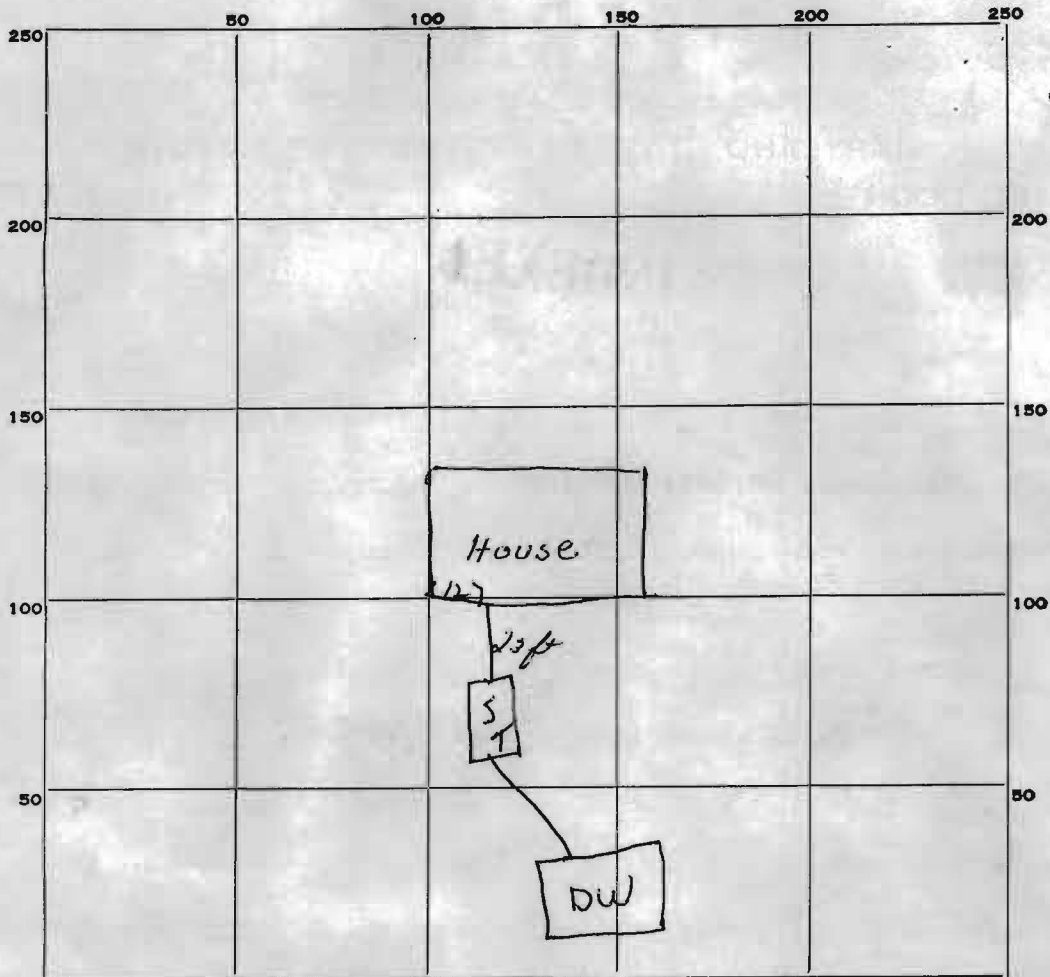

143
4
572

18
50
13
19
63

INDICATE NORTH. - NAME ADJOINING ROADWAY AS BASE LINE.

Cottlevan Ave

PERMIT CARD OK

SEPTIC TANK, LEVEL OK

CLEANOUTS OK

DISTRIBUTION BOX, LEVEL _____

TILE FIELD, DEPTH _____ FT. TRENCH WIDTH _____ FT.

GRAVEL DEPTH _____ IN. TOTAL LENGTH _____ FT.

NUMBER OF TRENCHES _____ TOTAL BOTTOM AREA _____

SEEPAGE PITS, *Perimeter* 63 ~~50~~ INSIDE DIAMETER _____ FT. DEPTH BELOW INLET 10 FT.

ABSORBENT AREA 630 SQ. FT.

REMARKS cut 3 ft below orig. grade -

DATE SYSTEM APPROVED 10/11/68

INSPECTOR DW Morgan