

APPLICATION

A 09003

SEWAGE DISPOSAL TESTING

P _____

MARYLAND STATE DEPARTMENT OF HEALTH

HOWARD COUNTY

*Septic tank - 750 gal. for 3 bedrooms
1,000 " " 4 "
1,500 " " 5 "*

ELLICOTT CITY

DISTRICT 3

DATE 9/9/64

Drywell - 143 sq. ft. absorbent sidewall area below inlet per bedroom

Locate drywell 40 ft from front lot line and 73 ft from right side line as lot is seen when facing it from Street "B"

TO: THE COUNTY HEALTH OFFICER
ELLICOTT CITY, MARYLAND

I, HEREBY, APPLY FOR THE NECESSARY TESTS IN ORDER TO CONSTRUCT (OR RECONSTRUCT) A SEWAGE DISPOSAL SYSTEM.

PROPERTY OWNER Burnt Woods Development Co., Inc.

ADDRESS 212 Crownwood Road, E. C., Md. PHONE HO 5-1345

PROPERTY LOCATION:

SUBDIVISION Burnt Wood LOT NO. 7, Blk. B, Sec. 8 ^{3pt,}

ROAD AND DESCRIPTION Castleton Drive
~~Street "B"~~

OCCUPANT _____ PHONE _____

PERSON TO CONSTRUCT SYSTEM _____

ADDRESS _____ PHONE _____

SIZE OF LOT 100' x 335' TYPE BLDG. test per bedroom
NUMBER OF BEDROOMS

IF NOT SINGLE RESIDENCE DESCRIBE _____

SIGNATURE OF APPLICANT /s/ M. A. Wakefield, Jr.


APPROVED BY Monegan - Fletcher FOR Drywell DATE 9/28/64
(KIND OF SYSTEM)

REJECTED BY _____ FOR _____ DATE _____
(KIND OF SYSTEM)

HOLD PENDING FURTHER TESTS _____ DATE _____

REASONS FOR REJECTION OR HOLDING _____

THIS IS NOT A PERMIT

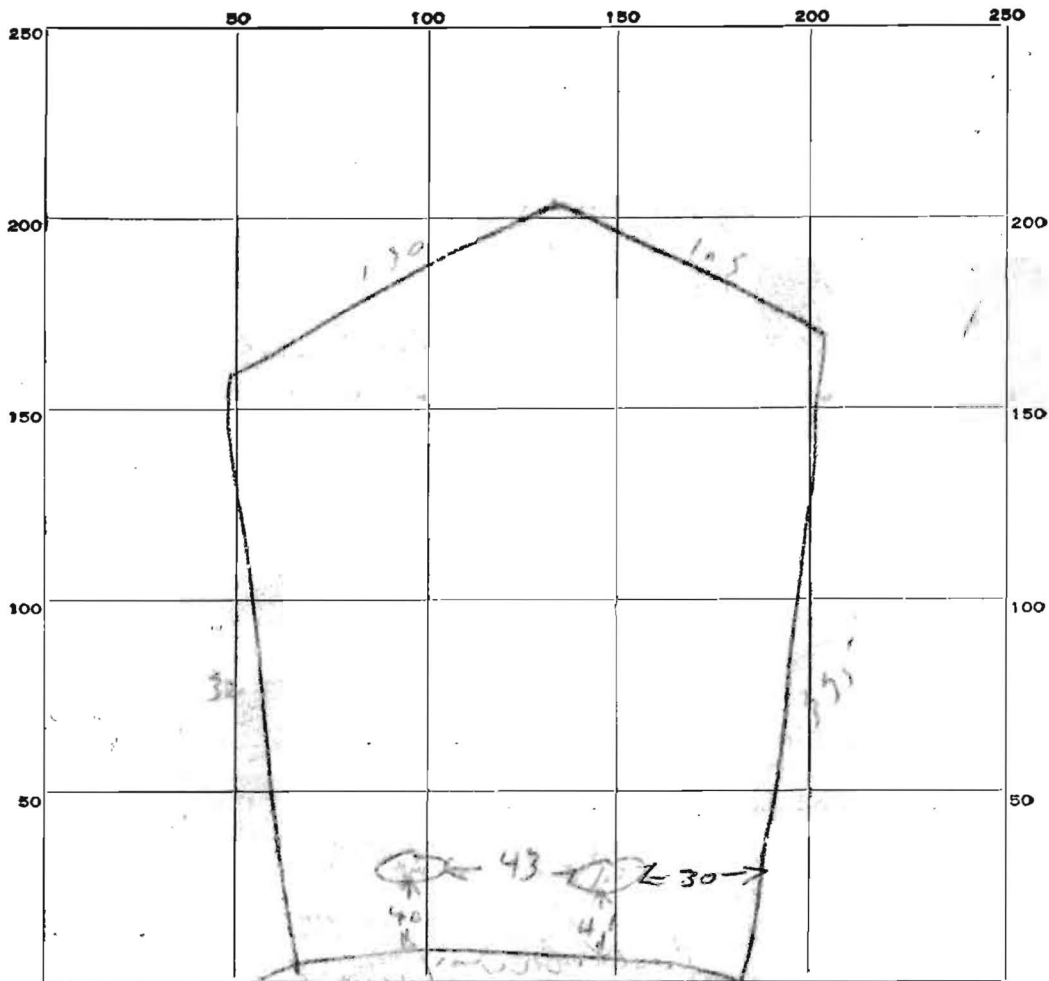

INDICATE NORTH. - NAME ADJOINING ROADWAY AS BASE LINE.

B. Street

DATE	TEST NO.	DEPTH	PRE-WET		TEST - 1" DROP		TIME
			START	STOP	START	STOP	
9/14/40	1	5 1/2 ft	1035	1050	1050	1050	100 perc
	2	10 1/2 ft	1035	1038	1038	1045	7mm
	3	5 1/2 ft	1039	1041	1041	1050	9mm
	4	10 1/2 ft	1038	1041	1041	1048	7mm

SOIL AUGER FINDING

TESTED BY

Don J. [unclear]

REMARKS

ALSO PRESENT

L Booth / [unclear]

LOT NO.

7 Box 3, part 1