


Lot No 7 Block B  
SECTION 3 PART 1  
BURNWOOD

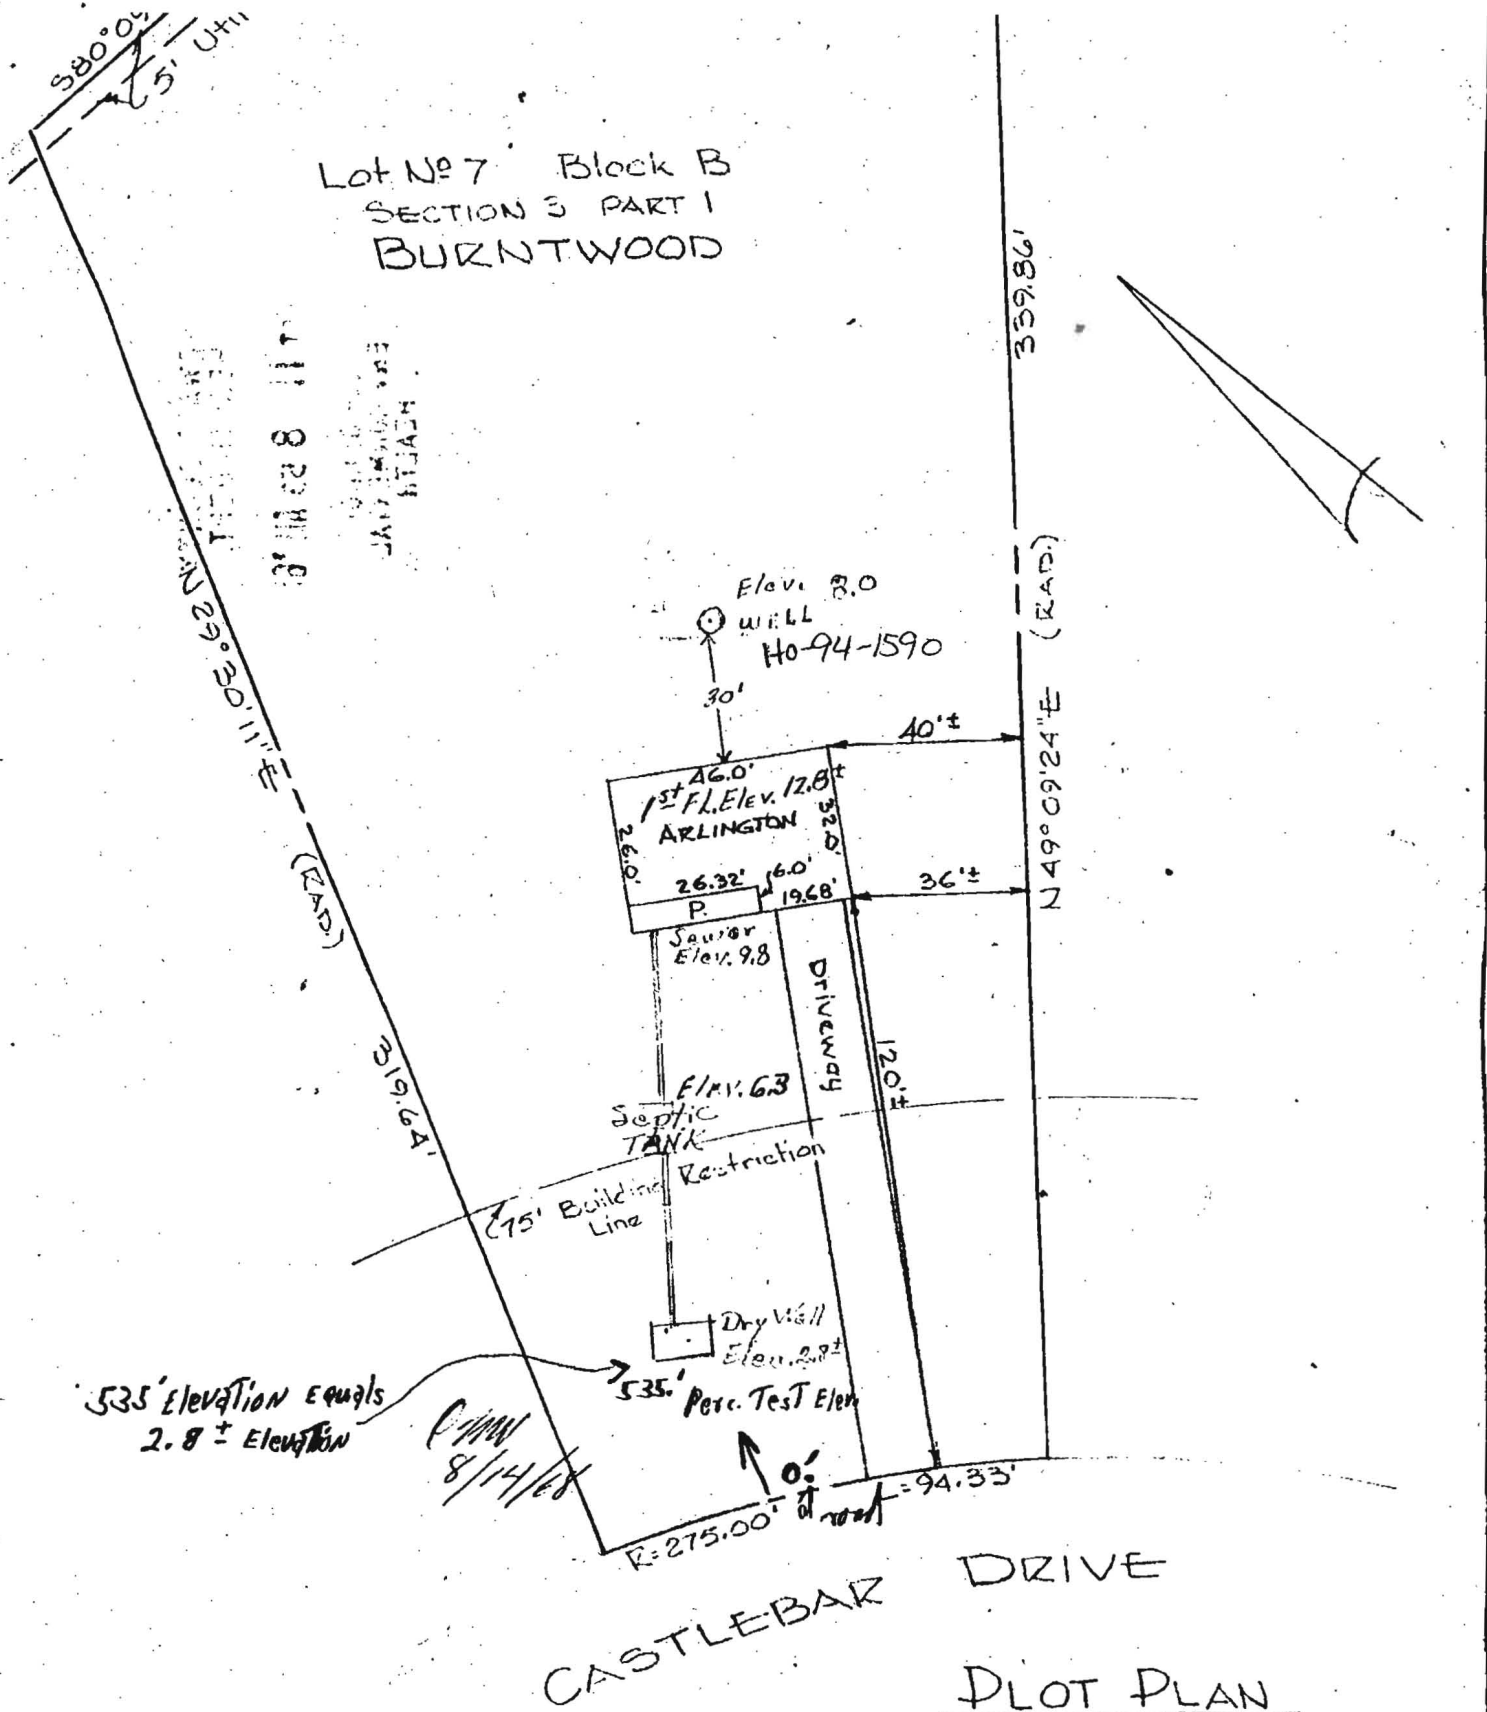

CASTLEBAR DRIVE

PLOT PLAN

Lot No 7 Block B  
SECTION ONE  
(PART ONE)

BURNWOOD

PURDUM & JESCHKE  
ENGINEERS  
24 PARK AVENUE  
ELLCOTT CITY, MARYLAND

3<sup>RD</sup> ELECTION DIST. HOWARD CO., MD.

JULY 31, 1968

SCALE: 1"=40'

REVISED: AUGUST 12, 1968