

PERMIT

SEWAGE DISPOSAL SYSTEM

MARYLAND STATE DEPARTMENT OF HEALTH

HOWARD COUNTY

ELLICOTT CITY

INDEXED

DISTRICT 3

DATE 4/15/68

P 13510
A 13255

HUDSON CONSTRUCTION CO.

IS PERMITTED TO INSTALL ALTER

ADDRESS 363 Chapel Ave., Ellicott City, Md.

PHONE 465-2205

A SEWAGE DISPOSAL SYSTEM LOCATED AT _____

SUBDIVISION _____ ROAD Triadelphia Rd. LOT _____

PROPERTY OWNER Eugene W. Sweigart

ADDRESS _____

SPECIFICATIONS - 3 bedrooms

DRAIN FIELD _____ DEPTH _____ FEET, BOTTOM AREA _____ SQ. FT.

SEEPAGE PITS _____ ABSORBENT SIDE-WALL AREA _____ SQ. FT.

SEPTIC TANK CAPACITY 750 GALLONS

FOR GARBAGE GRINDER, INCREASE DISPOSAL AREA 22% & TANK CAPACITY 50%.

OTHER Dry well - 300 sq. ft. sidewall area below the inlet with a maximum depth of 13 ft. For example one dry well 12 ft. in diameter and 8 ft. deep below the inlet pipe. Place the dry well 150 ft. to 170 ft. from the front lot line and 65 ft. to 85 ft. from the right side of the lot as seen when facing the lot from private dirt road. PERMIT VOID AFTER THREE YEARS.


PLANS APPROVED BY Raymond Hodges DATE 11/17/67

FILL SEPTIC TANK AND DISTRIBUTION BOX WITH WATER BEFORE CALLING FOR AN INSPECTION. COVER NO WORK UNTIL INSPECTED AND APPROVED.

NEITHER THE HOWARD COUNTY COMMISSIONERS NOR THE HEALTH DEPARTMENT IS RESPONSIBLE FOR THE SUCCESSFUL OPERATION OF ANY SYSTEM.

NOTIFY THE HEALTH DEPARTMENT 48 HOURS BEFORE EXCAVATIONS ARE TO BE BACK FILLED.

13255

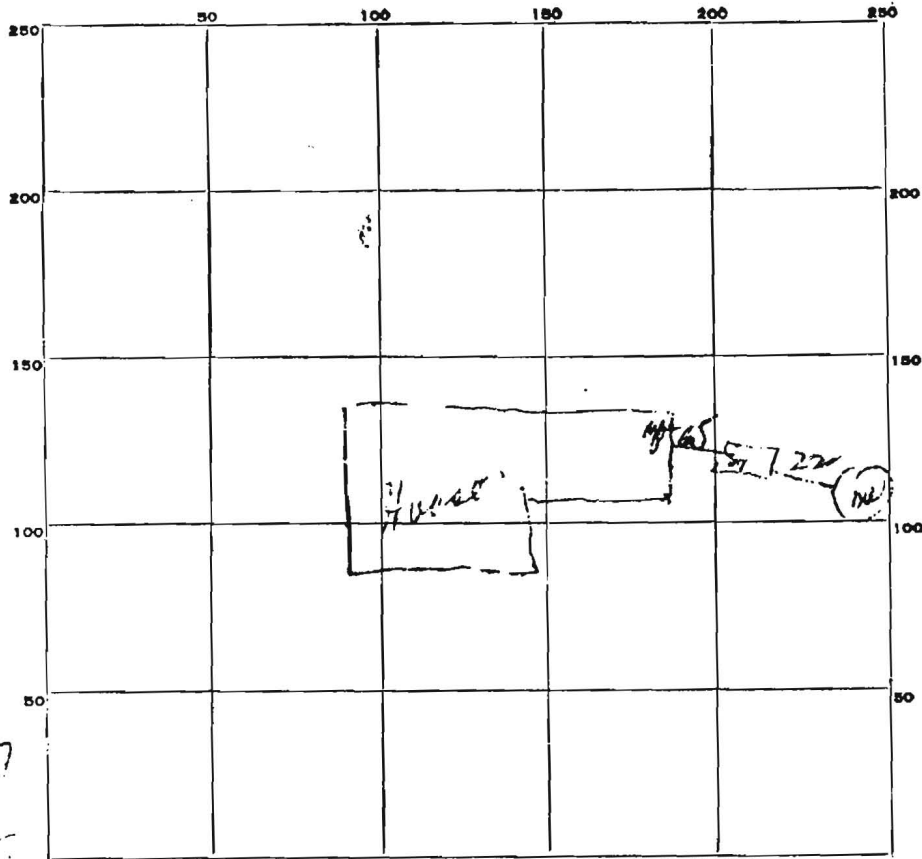

INDICATE NORTH. - NAME ADJOINING ROADWAY AS BASE LINE.

PERMIT CARD

SEPTIC TANK, LEVEL

CK-

CLEANOUTS

CK

DISTRIBUTION BOX, LEVEL _____

TILE FIELD, DEPTH _____ FT. TRENCH WIDTH _____ FT.

GRAVEL DEPTH _____ IN. TOTAL LENGTH _____ FT.

NUMBER OF TRENCHES _____ TOTAL BOTTOM AREA _____

SEEPAGE PITS, ^{out side} INSIDE DIAMETER 15 1/2 FT. DEPTH BELOW INLET 7 FT.

ABSORBENT AREA 341.6 SQ. FT.

REMARKS _____

DATE SYSTEM APPROVED

5.9.48

INSPECTOR

[Signature]