

5/4/04 Tues PM

PUB. SEWER STATUS VERIFIED BY _____

ISSUE DATE: 4/7/04
~~4/16/04~~

APPROVAL DATE: 5/4/04

520138-D
P ~~520305-B~~
REPAIR-TANK
A UPGRADE

PERMIT INDEXED

ON-SITE SEWAGE DISPOSAL SYSTEM
HOWARD COUNTY HEALTH DEPARTMENT
BUREAU OF ENVIRONMENTAL HEALTH

05-374987

Jack Fyock Septic Service _____ IS PERMITTED TO INSTALL ALTER

ADDRESS: P. O. Box 89, Glenelg 21737 PHONE NUMBER: 410-988-9270

SUBDIVISION: Glenelg Manor LOT NUMBER: 25-A

ADDRESS: 12847 Folly Quarter Road PROPERTY OWNER: Linda Kroeger

SEPTIC TANK CAPACITY (GALLONS): 2000

PUMP CHAMBER CAPACITY (GALLONS): _____

NUMBER OF BEDROOMS: _____

SQUARE FEET PER BEDROOM: _____

LINEAR FEET OF TRENCH REQUIRED: _____

TRENCHES:	Trench to be _____ feet wide. Inlet _____ feet below original grade. Bottom maximum depth _____ feet below original grade. Effective area begins at _____ feet below original grade. _____ feet of stone below distribution pipe.
LOCATION:	_____
PURPOSE:	Install a 2000 gallon septic tank for future building permit addition.

PLANS APPROVED: [Signature] DATE: 4/22/04

- NOTE: PERMIT VOID AFTER 2 YEARS
- NOTE: CONTRACTOR RESPONSIBLE FOR SCHEDULING A PRE-CONSTRUCTION INSPECTION FOR ALL INSTALLATIONS
- NOTE: WATERTIGHT SEPTIC TANKS REQUIRED
- NOTE: ALL PARTS OF SEPTIC SYSTEM SHALL BE 100 FEET FROM ANY WATER WELL
- NOTE: MANHOLE RISERS REQUIRED ON ALL SEPTIC TANKS AND PUMP CHAMBERS


NEITHER THE HOWARD COUNTY COUNCIL OR THE HEALTH DEPARTMENT IS RESPONSIBLE FOR THE SUCCESSFUL OPERATION OF ANY SYSTEM PERMITTEE RESPONSIBLE FOR OBTAINING FINAL APPROVAL ON THIS PERMIT CALL 410-313-2640 FOR INSPECTION OF SEPTIC SYSTEM

BUILDING PERMIT SIGNED AND RETURNED.

11-04 800147947- ADDITION

P520138-D

NOT TO SCALE

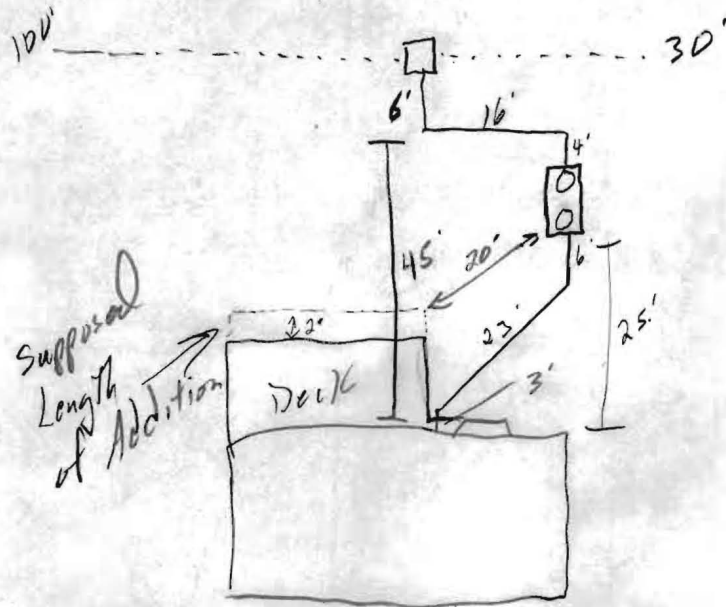

TRENCH/DRAINFIELD DATA		
WIDTH	INLET	BOTTOM
NUMBER OF TRENCHES	2	
TOTAL LENGTH	EX 130'	
ABSORPTION AREA		
DISTRIBUTION BOX LEVEL	✓	
DISTRIBUTION BOX BAFFLE		
DISTRIBUTION BOX PORT		

SEPTIC TANK DATA	
SEPTIC TANK 1 LEVEL	✓
Comp. CAPACITY	2000 GAL
SEAM LOC	TOP
TANK LID DEPTH	6"-1'
BAFFLES	✓
BAFFLE FILTER	—
MANHOLE LOC	F&B
6" PORT LOC	—
WATERTIGHT TEST	—
SEPTIC TANK 2 LEVEL	
CAPACITY	— GAL
SEAM LOC	—
TANK LID DEPTH	—
BAFFLES	N/A
BAFFLE FILTER	—
MANHOLE LOC	—
6" PORT LOC	—
WATERTIGHT TEST	—

PRE-CONSTRUCTION Tank moved to support B.P. to come.

INSTALLATION 5/4/04 - Tank installed. Old S.T. pumped, crushed, filled in. (SO)

BUILDING PERMIT SIGNED AND RETURNED

FINAL INSPECTOR [Signature] DATE OF APPROVAL 5/4/04