
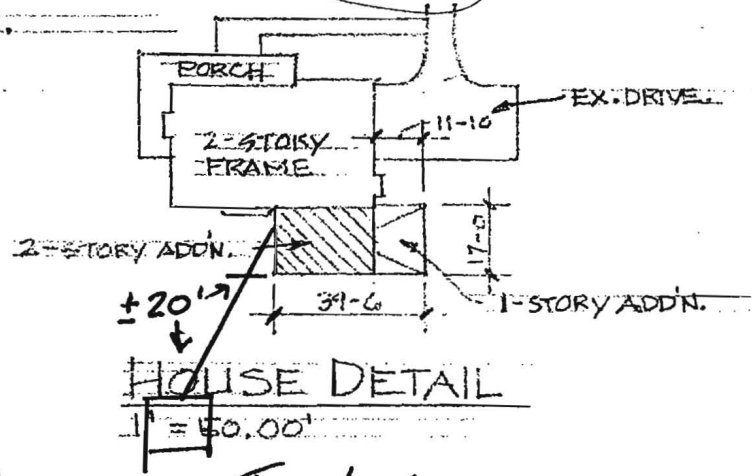


5/11/04


Proposed addition OK

KTB

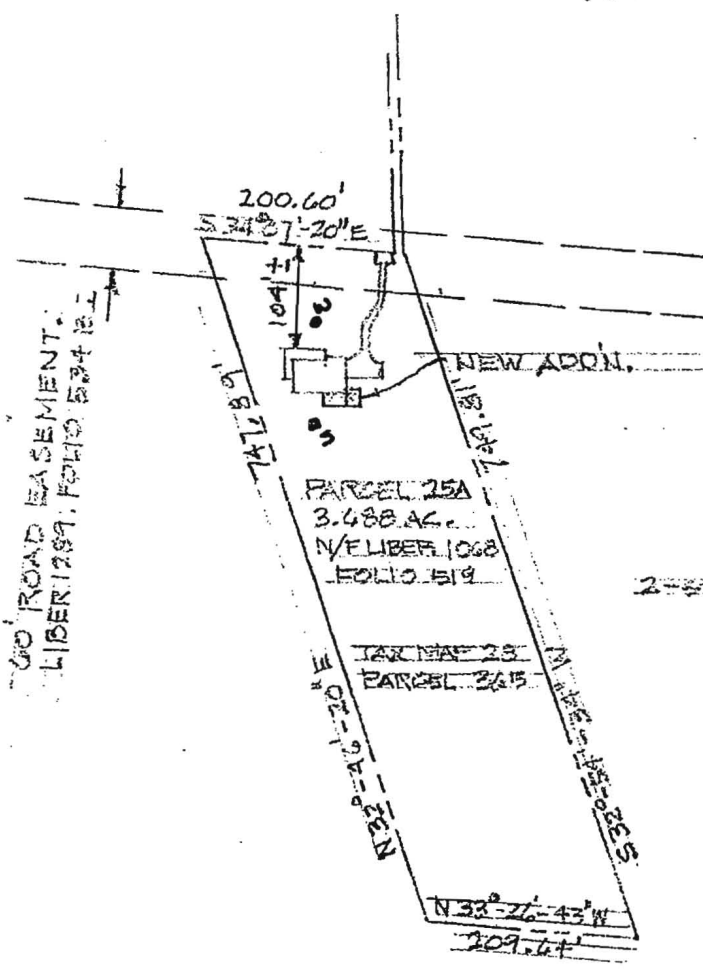

Tank has been moved.  
New location  
P-520138-D

SITE PLAN  
 1" = 200.00'

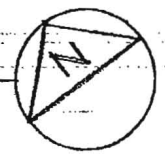

NOTE:

PROPERTY IS KNOWN AS PARCEL 25A,  
 12847 FOLLY QUARTER ROAD, GLENELG  
 MANOR II, 5<sup>TH</sup> ELECTION DISTRICT,  
 HOWARD COUNTY, MD.

THIS INFORMATION OBTAINED FROM  
 A LOCATION SURVEY DATED 9/25/05  
 PREPARED BY N.I.T. ASSOCIATES, INC.  
 16205 OLD FREDERICK ROAD  
 MOUNT AIRY, MD. 21771.

UP  
 2" = 1" = 100.00'