

ok out 6/25/60

PERMIT

P21949

A21900

SEWAGE DISPOSAL SYSTEM

MARYLAND STATE DEPARTMENT OF HEALTH

HOWARD COUNTY

ELLICOTT CITY

DISTRICT 5

INDEXED

DATE 11/28/59

C W Gannon IS PERMITTED TO INSTALL ALTER

ADDRESS Rt 2 Greencastle Rd Laurel PHONE _____

A SEWAGE DISPOSAL SYSTEM LOCATED AT Green Bridge Rd Dayton Md
1 mile south from Dayton on east side of road

SUBDIVISION _____ ROAD 5147 GREENBRIDGE RD LOT _____

PROPERTY OWNER C. W. Gannon

ADDRESS Rt 2 Greencastle Rd Laurel

SPECIFICATIONS

DRAIN FIELD _____ DEPTH _____ FEET, BOTTOM AREA _____ SQ. FT.

SEEPAGE PITS ABSORBENT SIDE-WALL AREA 300 SQ. FT. Only 3 persons

SEPTIC TANK CAPACITY 750 GALLONS are to use this
Dry Well

FOR GARBAGE GRINDER, INCREASE DISPOSAL AREA 22% & TANK CAPACITY 50%.


OTHER Place the Dry Well about 140 ft to 160 ft
from Green Bridge Rd and about 50 ft to 75 ft
from the side of the lot nearest T#32

PLANS APPROVED BY Raymond Hodges DATE 11/28/59

FILL SEPTIC TANK AND DISTRIBUTION BOX WITH WATER BEFORE CALLING FOR AN INSPECTION. COVER NO WORK UNTIL INSPECTED AND APPROVED.

NEITHER THE HOWARD COUNTY COMMISSIONERS NOR THE HEALTH DEPARTMENT IS RESPONSIBLE FOR THE SUCCESSFUL OPERATION OF ANY SYSTEM.

A 21900

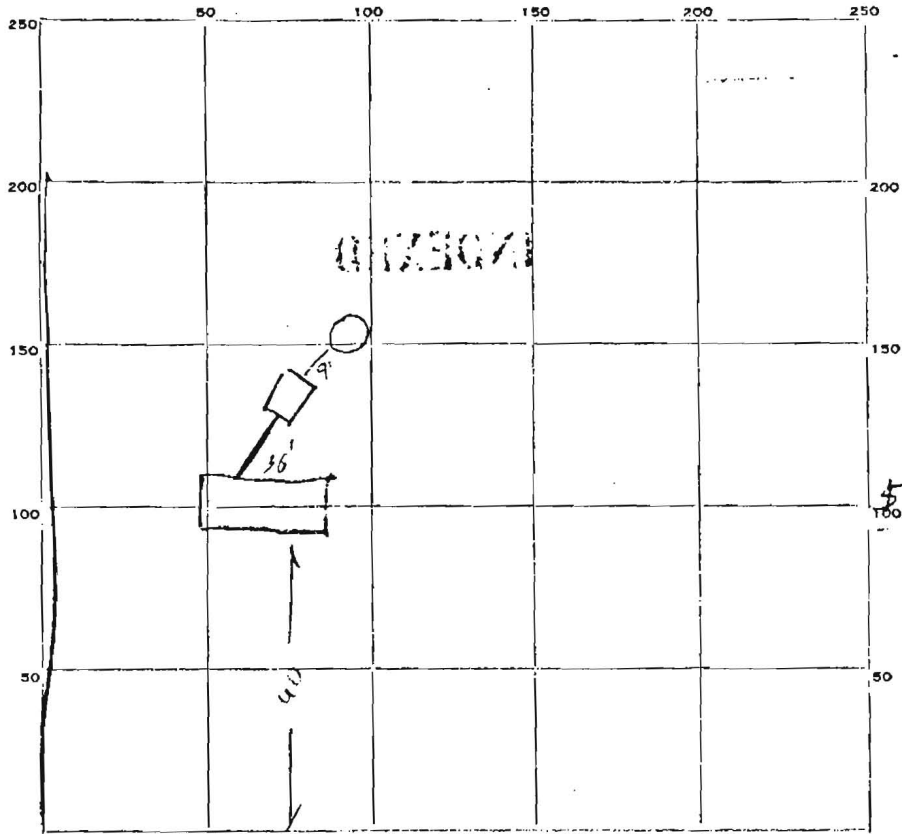

25
 75
 1.5
 375
 525
 52.5

INDICATE NORTH. - NAME ADJOINING ROADWAY AS BASE LINE.

PERMIT CARD None
 SEPTIC TANK, LEVEL skid 72 gallon CLEANOUTS big munks
 DISTRIBUTION BOX, LEVEL _____
 TILE FIELD, DEPTH _____ FT. TRENCH WIDTH _____ FT.
 GRAVEL DEPTH _____ IN. TOTAL LENGTH _____ FT.
 NUMBER OF TRENCHES _____ TOTAL BOTTOM AREA _____
 SEEPAGE PITS, INSIDE DIAMETER 9 FT. DEPTH BELOW INLET 12 FT.
 ABSORBENT AREA 336 SQ. FT.

REMARKS Home made 4' x 4' x 4' = 64 cu ft. 7' x 4' x 4' = 112 cu ft. 10' x 4' x 4' = 160 cu ft. = 316 cu ft. = 750 gal. per day. about 1 ft of gravel underneath. 10' x 4' x 4' = 160 gal. per day.

DATE SYSTEM APPROVED 6/2/51 INSPECTOR [Signature]