


A# 01900

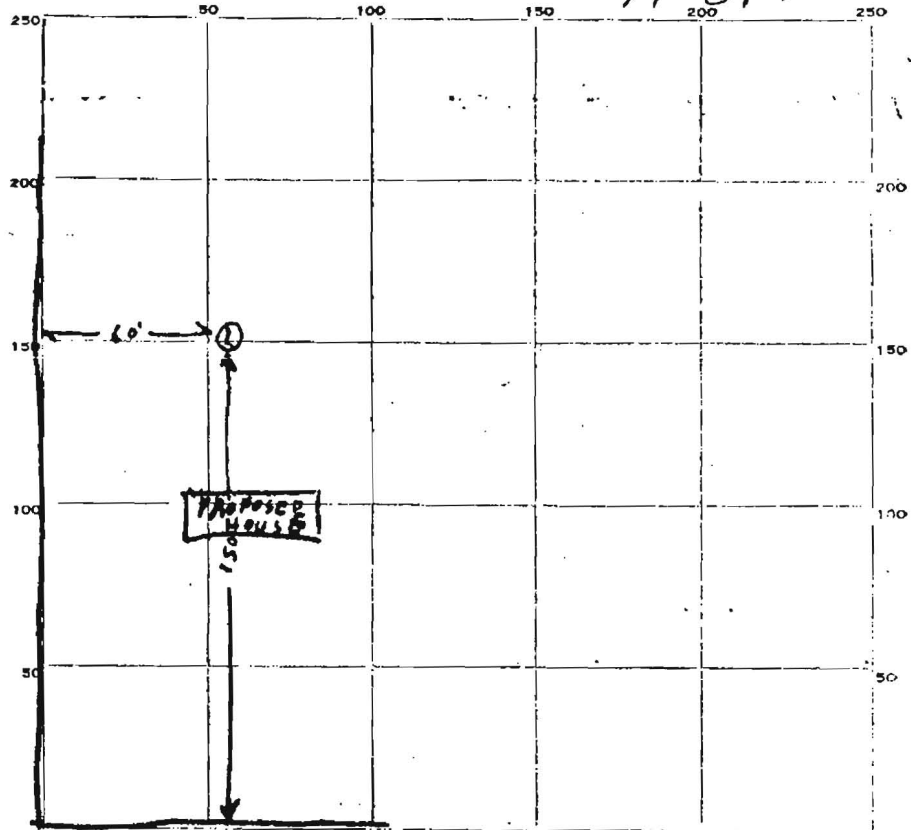

← TO RT #33

GREEN BRIDGE RD

DATE	TEST NO.	DEPTH	PRE-WET		TEST DROP		TIME
			START	STOP	START	STOP	
11/27	1	2' 10'	946	952	952	1004	12 min

SOIL AUGER FINDING _____

TESTED BY Raymond Hodges

REMARKS Only 3 systems used - use the system

ALSO PRESENT C.W. Hamon

LGT NO. _____