

APPLICATION

A 17371
P _____

SEWAGE DISPOSAL TESTING

MARYLAND STATE DEPARTMENT OF HEALTH

HOWARD COUNTY

ELLICOTT CITY

DISTRICT 1st

DATE 8/23/72

TO: THE COUNTY HEALTH OFFICER
ELLICOTT CITY, MARYLAND

I, HEREBY, APPLY FOR THE NECESSARY TESTS IN ORDER TO CONSTRUCT (OR RECONSTRUCT) A SEWAGE DISPOSAL SYSTEM.

PROPERTY OWNER Wendell Vollmer - Contract Purchaser

Any questions call Mrs. Bettie

ADDRESS Heckman, Beechwood Drive, Ellicott City, Md. PHONE Heckman, 744-8726

PROPERTY LOCATION:

SUBDIVISION (Ilchester Farms) LOT NO. 9

ROAD AND DESCRIPTION Ilchester Road

OCCUPANT _____ PHONE _____

PERSON TO CONSTRUCT SYSTEM _____

ADDRESS _____ PHONE _____

SIZE OF LOT 5,005 acres TYPE BLDG 3 or 4 bedrooms
NUMBER OF BEDROOMS

IF NOT SINGLE RESIDENCE DESCRIBE _____

SIGNATURE OF APPLICANT /s/ Bettie J. Heckman


APPROVED BY _____ FOR _____ DATE _____
(KIND OF SYSTEM)

REJECTED BY _____ FOR _____ DATE _____
(KIND OF SYSTEM)

HOLD PENDING FURTHER TESTS _____ DATE _____

REASONS FOR REJECTION OR HOLDING _____

THIS IS NOT A PERMIT

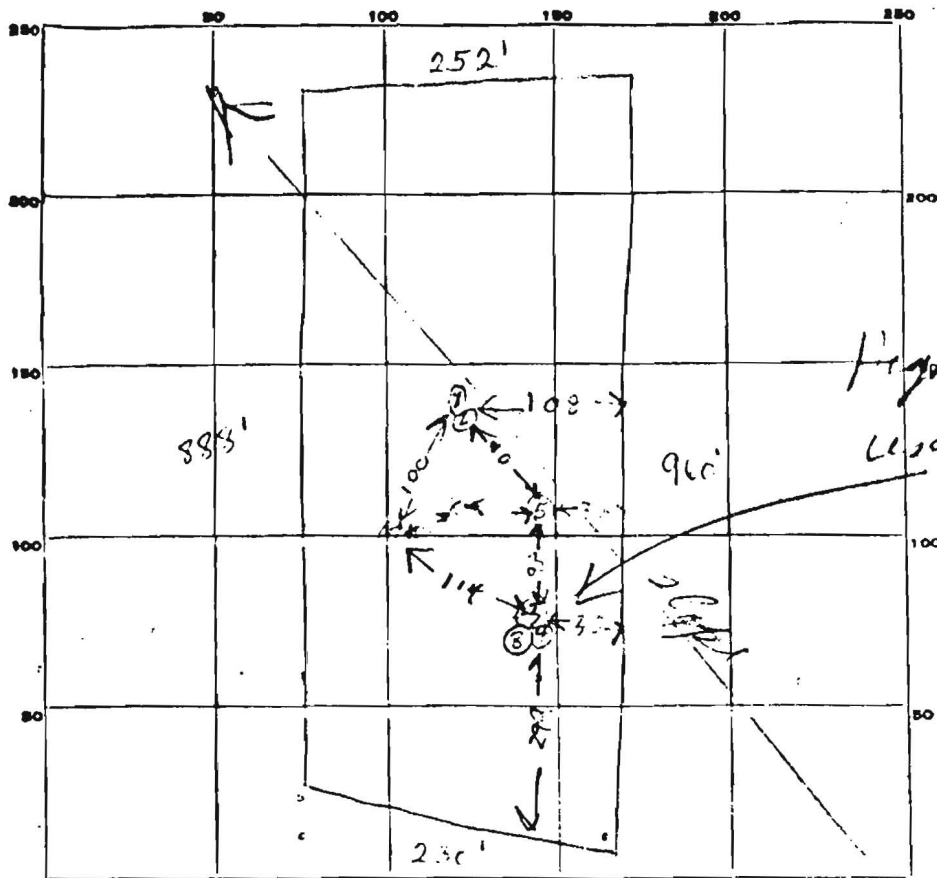

INDICATE NORTH. - NAME ADJOINING ROADWAY AS BASE LINE
 ILCHESTER ROAD

DATE	TEST NO.	DEPTH	PRE-WET		TEST - 1" DROP		TIME
			START	STOP	START	STOP	
9/19/73	1	12	122	176	126	134	8
	2	5	173	127	127	134	7
	3	11 1/2	139	141	141	145	3
	4	4	139	210	collec	1022	
	5	10	TOP 4" CLAY BOT OF 7 SAND		1707		
	6	10	TOP 4" CLAY BOT OF 7 SANDY		DRY		
	7	12	TOP 6" CLAY BOT OF 7 SANDY		DRY		
	8	4	206	207	207	209	2
		Avg	907				Avg 4.2

TOP OF CLAY
 BOT OF SAND

SOIL AUGER FINDING

TESTED BY

N. Wood

REMARKS