

82-178
H. H. Arnold

app 10-3-78

PERMIT

P 28616
A 17371

SEWAGE DISPOSAL SYSTEM

MARYLAND STATE DEPARTMENT OF HEALTH

HOWARD COUNTY

ELLCOTT CITY

DISTRICT 1st

INDEXED

DATE 8/1/78

Arnold Septic Tank Service IS PERMITTED TO INSTALL ALTER

ADDRESS 195-1285 PHONE _____

SUBDIVISION (Ilchester Farms) ROAD 4751 Ilchester Road LOT 9

PROPERTY OWNER Wendell Vollmer Jackson & Sandra Blake

ADDRESS 4732 Frederick Avenue, Balto., Md.

SPECIFICATIONS 3 bedrooms

SEPTIC TANK CAPACITY 1000 GALLONS

DRAIN FIELD _____ DEPTH _____ FEET. BOTTOM AREA _____ SQ. FT.

DEEP TRENCH _____ DEPTH _____ FEET. BOTTOM AREA _____ SQ. FT.

SEEPAGE PITS _____ ABSORBENT SIDE WALL AREA 300 SQ. FT. sidewall area below inlet.

INLET PIPE 5 FT. BELOW ORIGINAL GRADE. MAXIMUM DEPTH 12 FT. BELOW ORIGINAL GRADE

EFFECTIVE DEPTH AT 6 FT. BELOW ORIGINAL GRADE

LOCATE DISPOSAL AREA 299 FT. FROM front LOT LINE AND 30 FT. FROM right LOT LINE AS SEEN WHEN
FACING LOT FROM Ilchester Road.

PLANS APPROVED BY Raunold Hodges DATE 9/26/72

COVER NO WORK UNTIL INSPECTED AND APPROVED

NEITHER THE HOWARD COUNTY COUNCIL NOR THE HEALTH DEPARTMENT IS RESPONSIBLE FOR THE SUCCESSFUL OPERATION OF ANY SYSTEM

NOTE IF TRENCH IS USED CALL FOR INSPECTION BEFORE PLACING GRAVEL IN TRENCH

NOTE NO DRY WELL SHALL EXCEED 15 FOOT IN DIAMETER

NOTE ALL PIPE FROM HOUSE TO DISPOSAL AREA MUST BE CAST IRON


PERMIT VOID AFTER THREE YEARS

NOTE INSTALL STAND PIPE ON SEPTIC TANK AND DRY WELL. STAND PIPES MUST BE 6 INCHES IN DIAMETER. CAST IRON, CONCRETE OR TERRA
COTTA ACCEPTED

*INSTALLER IS RESPONSIBLE FOR OBTAINING FINAL APPROVAL ON THIS PERMIT.

BLD. PERMIT SECT. 11/04/74
AND RETURNED Serial # 57186-312

A17371

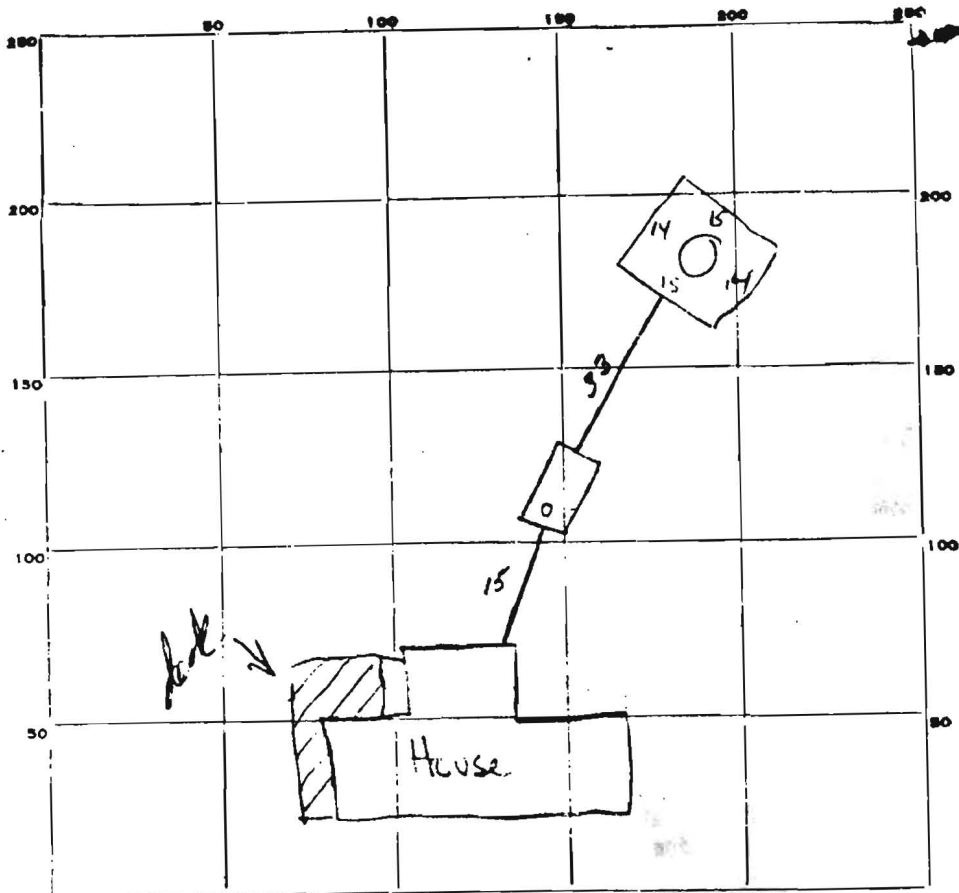

INDICATE NORTH - NAME ADJOINING ROADWAY AS BASE LINE.

Hochester Rd

PERMIT CARD

SEPTIC TANK, LEVEL

1250 gal

CLEANOUTS

ST	DW	CAST IRON
<input checked="" type="checkbox"/>	<input checked="" type="checkbox"/>	<input checked="" type="checkbox"/>

DISTRIBUTION BOX, LEVEL No

TILE FIELD, DEPTH No FT.

TRENCH WIDTH _____ FT.

GRAVEL DEPTH _____ IN.

TOTAL LENGTH _____ FT.

NUMBER OF TRENCHES _____

TOTAL BOTTOM AREA _____

SEEPAGE PITS, INSIDE DIAMETER

50

FT.

DEPTH BELOW INLET

7

FT.

406

ABSORBENT AREA

±406

SQ. FT.

REMARKS

2 Aug '78 - Slope of house sewer too great; 1 3/4" drop per foot. Slope must be changed. OK to bracket from inlet tank to cleanout. Call when slope is corrected (CLR)

DATE SYSTEM APPROVED

10/3/78

INSPECTOR

Bill Murray