

4/13/04 9:30-10:00

03299775

PUB. SEWER STATUS VERIFIED BY \_\_\_\_\_

ISSUE DATE: 4/5/04

P 520134

APPROVAL DATE: 4/19/04

A REPAIR

# PERMIT INDEXED

## ON-SITE SEWAGE DISPOSAL SYSTEM HOWARD COUNTY HEALTH DEPARTMENT BUREAU OF ENVIRONMENTAL HEALTH

Freedom Septic *Tank is concrete* IS PERMITTED TO INSTALL  ALTER

ADDRESS: 2809 Liberty Road, Sykesville PHONE NUMBER: 210-795-2947

SUBDIVISION: \_\_\_\_\_ LOT NUMBER: \_\_\_\_\_

ADDRESS: 11762 Carroll Mill Road PROPERTY OWNER: ~~Lawrence Lustig~~ *JOHN REIGERT*

SEPTIC TANK CAPACITY (GALLONS): \_\_\_\_\_

PUMP CHAMBER CAPACITY (GALLONS): \_\_\_\_\_

NUMBER OF BEDROOMS: 3'

SQUARE FEET PER BEDROOM: 240'

LINEAR FEET OF TRENCH REQUIRED: 200'

*200' of Trench  
3' Wide Bottom at 5'  
Inlet at 3.5'-4' (Up  
to Contractor)  
1'-1.5' of stone*

TRENCHES:	Trench to be _____ feet wide. Inlet _____ feet below original grade. Bottom maximum depth _____ feet below original grade. Effective area begins at _____ feet below original grade. _____ feet of stone below distribution pipe.
LOCATION:	
PURPOSE:	Existing septic system has failed. Call for inspection when ground is opened so sanitarian can recommend repair.

PLANS APPROVED: \_\_\_\_\_ DATE: \_\_\_\_\_

- NOTE: PERMIT VOID AFTER 2 YEARS
- NOTE: CONTRACTOR RESPONSIBLE FOR SCHEDULING A PRE-CONSTRUCTION INSPECTION FOR ALL INSTALLATIONS
- NOTE: WATERTIGHT SEPTIC TANKS REQUIRED
- NOTE: ALL PARTS OF SEPTIC SYSTEM SHALL BE 100 FEET FROM ANY WATER WELL
- NOTE: MANHOLE RISERS REQUIRED ON ALL SEPTIC TANKS AND PUMP CHAMBERS

NEITHER THE HOWARD COUNTY COUNCIL OR THE HEALTH DEPARTMENT IS RESPONSIBLE FOR THE SUCCESSFUL OPERATION OF ANY SYSTEM


PERMITTEE RESPONSIBLE FOR OBTAINING FINAL APPROVAL ON THIS PERMIT

CALL 410-313-2640 FOR INSPECTION OF SEPTIC SYSTEM

**BUILDING PERMIT SIGNED AND RETURNED**

*7-7-04 BOB 149301 - Family Am Addition  
10-13-04 BOB 15062 - 116 LP TANK*

NOT TO SCALE

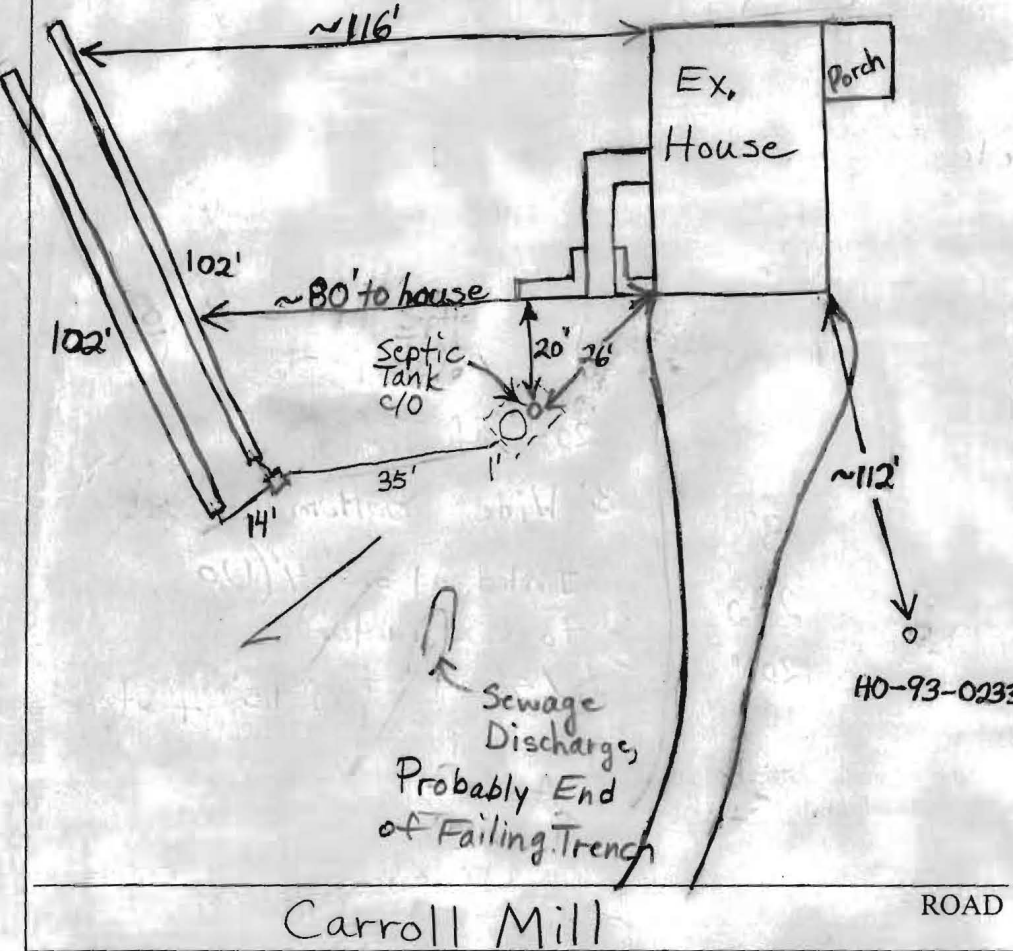

TRENCH/DRAINFIELD DATA		
WIDTH	INLET	BOTTOM
3'	3.5'	5'
NUMBER OF TRENCHES	2	
TOTAL LENGTH	204	
ABSORPTION AREA	612 sq ft	
DISTRIBUTION BOX LEVEL	Levelers	
DISTRIBUTION BOX BAFFLE	Yes	
DISTRIBUTION BOX PORT	No	

SEPTIC TANK DATA	
SEPTIC TANK 1 LEVEL	Existing
CAPACITY	1000+? GAL
SEAM LOC	Mid
TANK LID DEPTH	18"
BAFFLES	Existing
BAFFLE FILTER	No
MANHOLE LOC	Back
6" PORT LOC	Front
WATERTIGHT TEST	No
SEPTIC TANK 2 LEVEL	N/A
CAPACITY	_____ GAL
SEAM LOC	_____
TANK LID DEPTH	_____
BAFFLES	_____
BAFFLE FILTER	_____
MANHOLE LOC	_____
6" PORT LOC	_____
WATERTIGHT TEST	_____

PRE-CONSTRUCTION 4/13/04 Install 2-100' trenches on contour in the area of holes A, C+D. Trenches should be 3' wide and no deeper than 5'. See the perc. test sheet for hole locations. The septic tank is supposed to be pumped out. The tank volume will determine the need for the installation of a second 500 gallon tank. (BB) 4/19/04 Existing concrete tank at least 1000 gallon per Freedom System satisfactory. O.K. to cover. (BB)

BUILDING PERMIT SIGNED AND RETURNED

FINAL INSPECTOR B. Baber

DATE OF APPROVAL 4/19/04