

APPLICATION

PERCOLATION TESTING

A 43428

P _____

HOWARD COUNTY HEALTH DEPARTMENT
BUREAU OF ENVIRONMENTAL HEALTH
P O BOX 476 ELLICOTT CITY, MARYLAND 21043
TELEPHONE: 461-9933

DISTRICT R

DATE 12/19/88

TO: THE COUNTY HEALTH OFFICER
ELLICOTT CITY, MARYLAND

I, HEREBY, APPLY FOR THE NECESSARY TEST IN ORDER TO CONSTRUCT (OR RECONSTRUCT) A SEWAGE DISPOSAL SYSTEM.

PROPERTY OWNER Oakton Associates, Inc. *Martin II, Inc*

ADDRESS 1200 18th Street, NW, Washington, DC 20036 PHONE 239-8330
(202) 457-8637

PROSPECTIVE BUYER Anchor Capital Group

ADDRESS 133 Defense Highway, Suite 206 PHONE (301) 261-8727
Annapolis, MD 21401

PROPERTY LOCATION:

SUBDIVISION Cabin Branch Farm LOT NO. 52 / 49

ROAD AND DESCRIPTION Rte 94 (Ellicott Road) Approximately 2 miles North East
from Damascus Road (3221 Hayloft Court)

TAX MAP 13 PARCEL # 42

SIZE OF LOT 3 acres TYPE BLDG. Single Family
(SINGLE FAMILY DWELLING OR COMMERCIAL)

THE SYSTEM INSTALLED UNDER THIS APPLICATION IS ACCEPTABLE ONLY UNTIL PUBLIC FACILITIES BECOME AVAILABLE. I FULLY UNDERSTAND THE FEE CONNECTED WITH THE FILING OF THIS PERC TEST APPLICATION IS NON-REFUNDABLE UNDER ANY CIRCUMSTANCES. I ALSO AGREE TO COMPLY WITH ALL M.O.S.H.A. REQUIREMENTS IN TESTING THIS LOT.

James Hanna
(SIGNATURE OF APPLICANT)

APPROVED BY _____ FOR _____ DATE _____

REJECTED BY _____ FOR _____ DATE _____

HOLD-PENDING FURTHER TESTS _____ DATE _____

REASONS FOR REJECTION OR HOLDING 4/13/89 Perc Op. Hold on lot #1



BLDG PERMIT SIGNED
AND RETURNED 7/5/89
Seaville 59608
SFD-3/Burn

HD-216

THIS IS NOT A PERMIT

Lot 52
A4342e
14




SOIL PROFILE

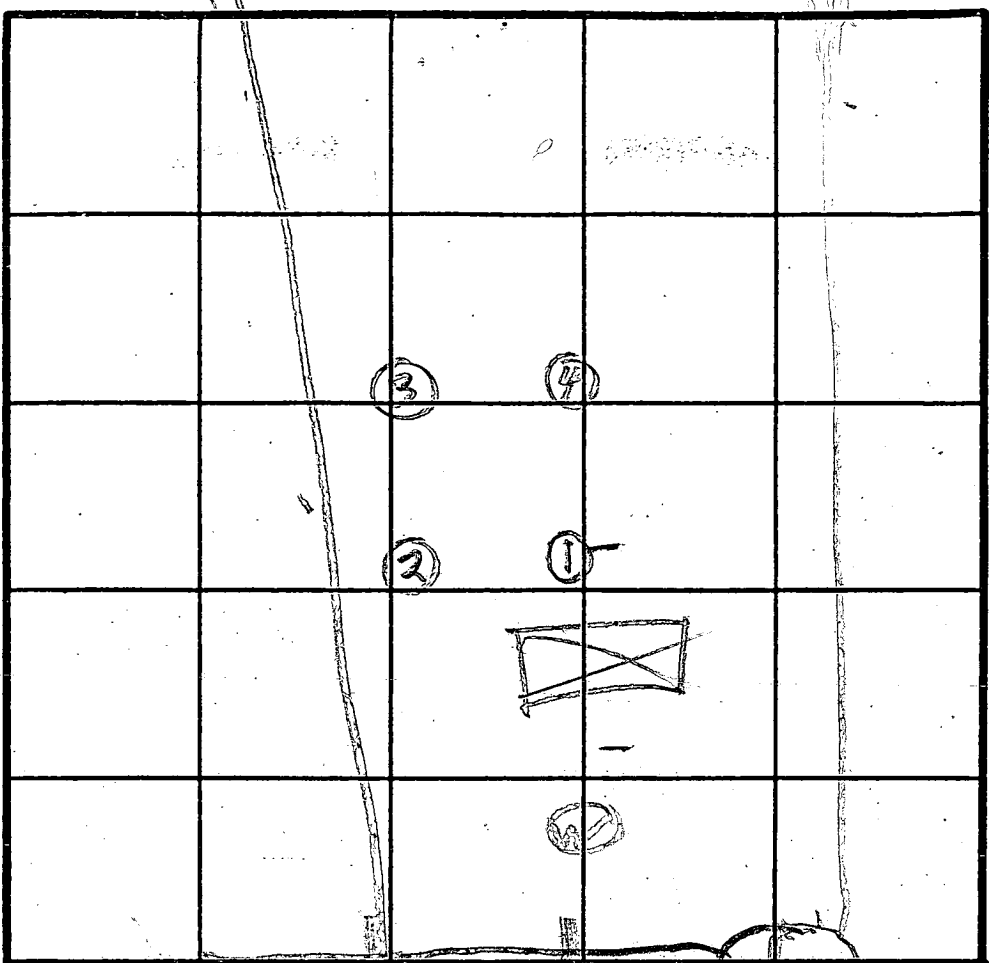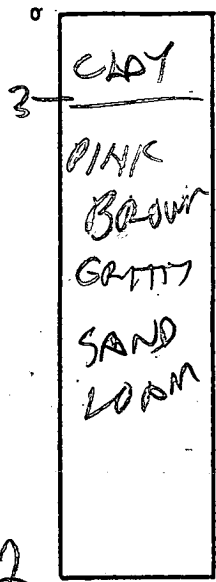

INLET 3'
X 5 MIN

INDICATE NORTH NAME ADJOINING ROADWAY AS BASE LINE.

UNNAMED COURT

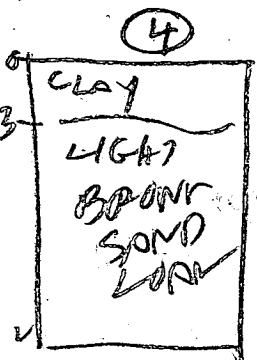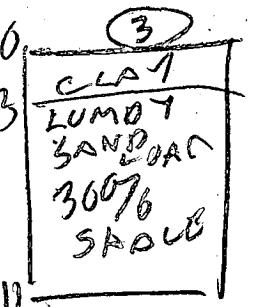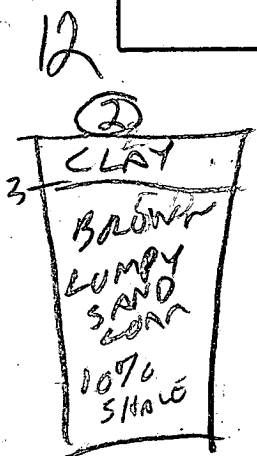

DATE	TEST NO.	DEPTH	PRE-WET		TEST - 1" DROP		TIME
			START	STOP	START	STOP	
4/18/29	I S	4	310	313	313	321	84
	I R	7.5	316	313	313	317	
I	IV	12	OK				
	2 S	4	326	331	331	335	4
A	2 V	10.5	OK				
	3 S	3.5	328	330	330	336	6
J	2 V	11	OK		SHALE LOAM		
	4 V	12					

REMARKS: Hole (1)(2)(3)(4) Dry Per Test Plat R/H

TYPE OF SOIL: _____
 TESTED BY: R HODGES
 ALSO PRESENT: JAMES E. ... ROY