

6/25/68
9:30

Retest
APPLICATION

A 13670

SEWAGE DISPOSAL TESTING

P _____

MARYLAND STATE DEPARTMENT OF HEALTH

HOWARD COUNTY

ELLICOTT CITY

Septic Tank - 750 gal

DISTRICT 4

DATE 6/21/68

Dry Well - dig pit 16ft sq - set block and top for 12ft diameter and fill in rest of pit with gravel. Dry Well to be 8ft deep below inlet pipe. Inlet pipe to be 34ft below original grade.

Place Dry Well about 130 ft from front lot line and about 18ft from left side line. If above location cannot be used - use following specs: 2 Dry Wells each 6 to 16ft sq block and top for 12ft diameter - fill in rest of pit with gravel. Each dry well to be 6ft deep below inlet pipe - inlet pipe to be 4ft below original grade. Place each dry well 60ft behind house with one dry well 30 ft from left side line and second dry well about 80ft from left side line as shown accompanying plan Duvall Rd.

I, HEREBY, APPLY FOR THE NECESSARY TESTS IN ORDER TO CONSTRUCT OR RECONSTRUCT A SEWAGE DISPOSAL SYSTEM.

PROPERTY OWNER Boswell * dry wells must be 48ft apart edge to edge.

ADDRESS _____ PHONE _____

PROPERTY LOCATION: _____

SUBDIVISION River Farms, Inc. LOT NO. 21, Sec. 2

ROAD AND DESCRIPTION Duvall Rd.

OCCUPANT _____ PHONE _____

PERSON TO CONSTRUCT SYSTEM _____

ADDRESS _____ PHONE _____

SIZE OF LOT 1.774 acres TYPE BLDG. 3
NUMBER OF BEDROOMS

IF NOT SINGLE RESIDENCE DESCRIBE _____

SIGNATURE OF APPLICANT Joseph W. McVicker


APPROVED BY Bill Worthington FOR Dry Well DATE 6-25-68
(NAME OF SYSTEM)

REJECTED BY _____ FOR _____ DATE _____
(NAME OF SYSTEM)

HOLD PENDING FURTHER TESTS _____ DATE _____

REASONS FOR REJECTION OR HOLDING _____

19
2
5

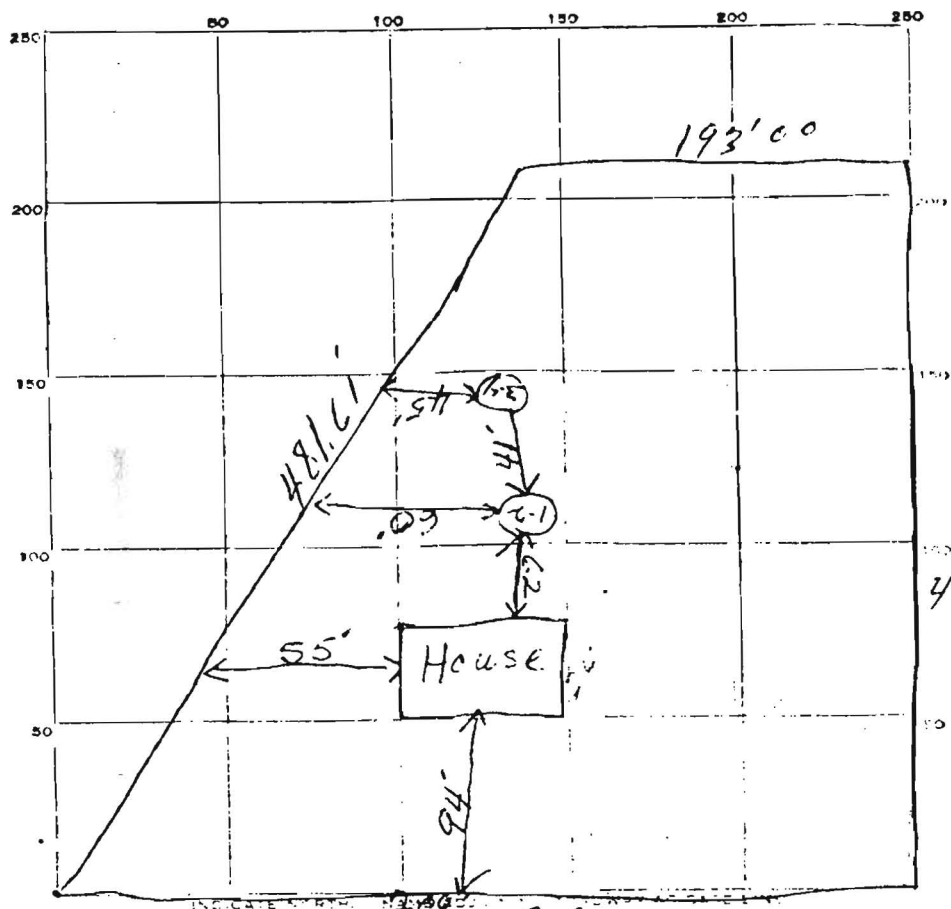

44
20
10

448.67

Durall Rd

DATE	TEST NO.	DEPTH	PRE-WET		TEST		DROPS	TIME
			START	STOP	START	STOP		
6/25/00	1	10'	9:52	10:15	10:15	10:45	30	
	2	4'	9:58	10:01	10:01	10:13	12	
	3	10'	10:03	10:07	10:07	10:29	18	
	4	4'	10:03	10:08	10:08	10:14	6	
	5	11'	10:24	10:44	10:44	11:15	30	

SOIL AUGER FINDING