

7/12/68

7/12/68
2527

PERMIT

P. 13720

A. 13670

SEWAGE DISPOSAL SYSTEM

MARYLAND STATE DEPARTMENT OF HEALTH

HOWARD COUNTY

INDEXED

ELLICOTT CITY

DISTRICT 4

DATE 7/9, 68

Herman Sirk IS PERMITTED TO INSTALL ALTER

ADDRESS Annapolis Rock Road, Woodbine, Md. PHONE HU 9-4724

A SEWAGE DISPOSAL SYSTEM LOCATED AT _____

SUBDIVISION River Farms, Inc. ROAD Duvall LOT 21, Sec. 2

PROPERTY OWNER Boswell

ADDRESS _____

SPECIFICATIONS - 3 bedrooms

DRAIN FIELD _____ DEPTH _____ FEET, BOTTOM AREA _____ SQ. FT.

SEEPAGE PITS _____ ABSORBENT SIDE-WALL AREA _____ SQ. FT.

SEPTIC TANK CAPACITY 750 GALLONS

FOR GARBAGE GRINDER, INCREASE DISPOSAL AREA 22% & TANK CAPACITY 50%

OTHER Dry well - dig pit 16 ft. sq. - set block and top for 12 ft. diameter and fill in rest of pit with gravel. Dry well to be 8 ft. deep below inlet pipe. Inlet pipe to be 3 to 4 ft. below original grade.

Place dry well about 130 ft. from front lot line and about 18 ft. from left side line. If above location cannot be used - use the following specifications:

2 dry wells - each to be 16 ft. sq. set block and top for 12 ft. dia. - fill in rest of pit with gravel. Each dry well to be 6 ft. deep below inlet pipe - inlet pipe to be 4 ft. below original grade. Place each dry well 60 ft. behind house with one dry well 30 ft. from left side line and second dry well about 80 ft. from left side line as seen when facing from Duvall Rd. * Dry wells must be 48 ft. apart


PLANS APPROVED BY D. W. Monaghan DATE 6/25/68
edge to edge. PERMIT VOID AFTER THREE YEARS.

FILL SEPTIC TANK AND DISTRIBUTION BOX WITH WATER BEFORE CALLING FOR AN INSPECTION. COVER NO WORK UNTIL INSPECTED AND APPROVED.

NEITHER THE HOWARD COUNTY COMMISSIONERS NOR THE HEALTH DEPARTMENT IS RESPONSIBLE FOR THE SUCCESSFUL OPERATION OF ANY SYSTEM.

DEPARTMENT OF HEALTH

6/15

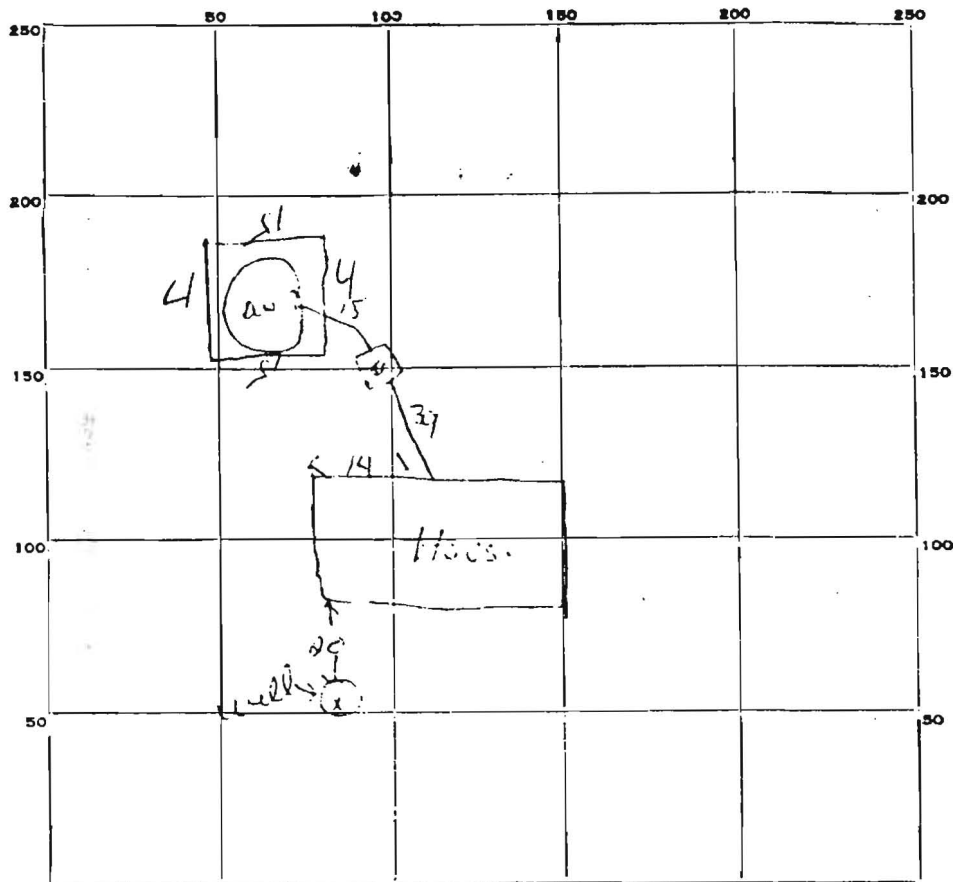

INDICATE NORTH. - NAME ADJOINING ROADWAY AS BASE LINE.

Small Road

PERMIT CARD OK

SEPTIC TANK, LEVEL OK

CLEANOUTS OK

DISTRIBUTION BOX, LEVEL _____

TILE FIELD, DEPTH _____ FT. TRENCH WIDTH _____ FT.

GRAVEL DEPTH _____ IN. TOTAL LENGTH _____ FT.

NUMBER OF TRENCHES _____ TOTAL BOTTOM AREA _____

SEEPAGE PITS, INSIDE DIAMETER 64 FT. DEPTH BELOW INLET 8 FT.

ABSORBENT AREA 512 SQ. FT.

REMARKS _____

