

APPLICATION

A 17929

SEWAGE DISPOSAL TESTING

P _____

STATE OF MARYLAND - DEPARTMENT OF HEALTH AND MENTAL HYGIENE

HOWARD COUNTY HEALTH DEPARTMENT
ENVIRONMENTAL HEALTH SERVICES

DISTRICT 4th

P. O. BOX 476, ELLICOTT CITY, MARYLAND 21043
TELEPHONE: 465-5000, EXT. 358

DATE 2/9/73

TO: THE COUNTY HEALTH OFFICER
ELLICOTT CITY, MARYLAND

I, HEREBY, APPLY FOR THE NECESSARY TEST IN ORDER TO CONSTRUCT (OR RECONSTRUCT) A SEWAGE DISPOSAL SYSTEM.

PROPERTY OWNER Mordecai Hoseh

ADDRESS Woodbine, Maryland

Any questions call Louise Adams,
PHONE Pierre Dugan Realty Co.

PROPERTY LOCATION:

SUBDIVISION _____ LOT NO. _____

ROAD AND DESCRIPTION Florence Daisy Road

SIZE OF LOT 5.036 acres TYPE BLDG. 3 or 4 bedrooms

NUMBER OF BEDROOMS

IF NOT SINGLE RESIDENCE DESCRIBE _____

THE SYSTEM INSTALLED UNDER THIS APPLICATION IS ACCEPTABLE ONLY UNTIL PUBLIC FACILITIES BECOME AVAILABLE.

SIGNATURE OF APPLICANT /s/ Louise Adams


APPROVED BY _____ FOR _____ DATE _____
(KIND OF SYSTEM)

REJECTED BY _____ FOR _____ DATE _____
(KIND OF SYSTEM)

HOLD PENDING FURTHER TESTS _____ DATE _____

REASONS FOR REJECTION OR HOLDING _____

THIS IS NOT A PERMIT

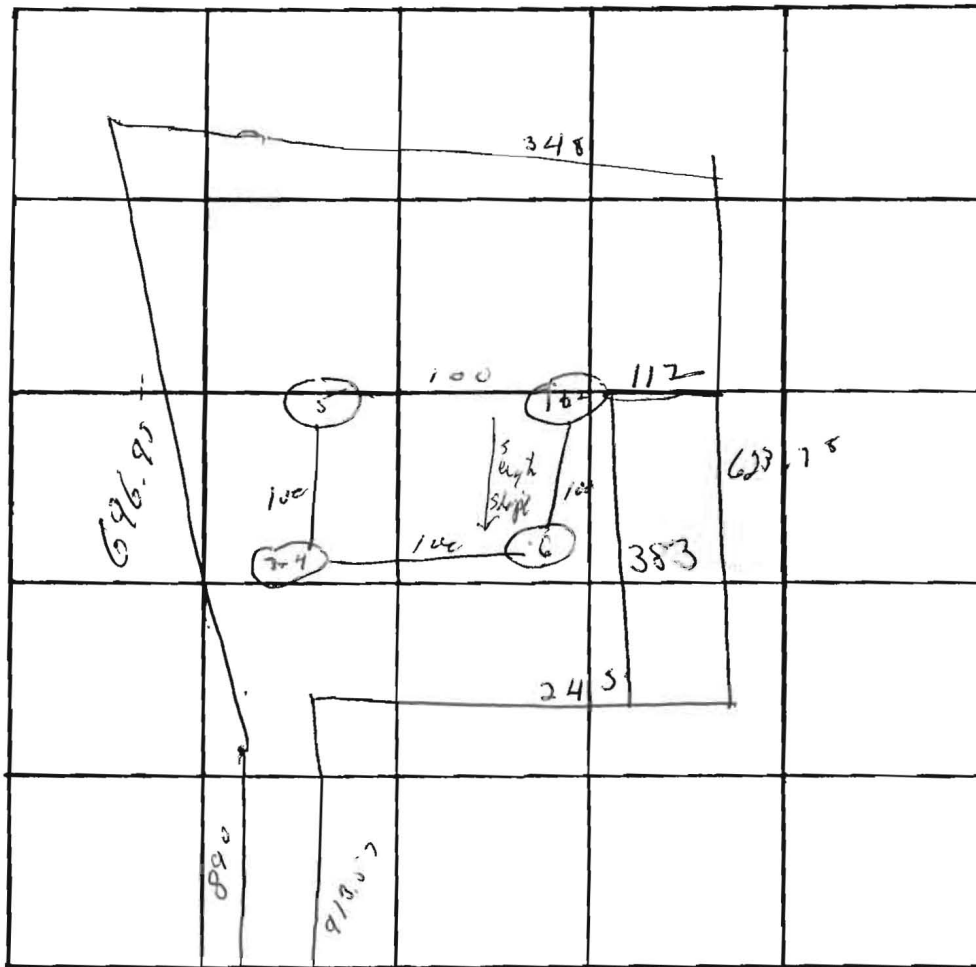

INDICATE NORTH. - NAME ADJOINING ROADWAY AS BASE LINE.

Florence R.

DATE	TEST NO.	DEPTH	PRE-WET		TEST - 1" DROP		TIME	
			START	STOP	START	STOP		
2/27/73	1	1 1/2 ft	10 33	10 40	10 40	10 55	15 min	
	2	12 ft	10 33	10 37	10 37	10 47	10 min	
	3	1 1/2 ft	10 35	10 42	10 42	11 00	18 min	
	4	12 ft	10 37	10 40	10 40	10 53	13 min	
	5	not tested - same type soil						
	6							

REMARKS: Pit 12 - highest - 304 lowest

TYPE OF SOIL _____

TESTED BY DEM ALSO PRESENT: _____

APPLICATION

A 17929

2/22/73 A.M.
9:30

SEWAGE DISPOSAL TESTING

P _____

STATE OF MARYLAND - DEPARTMENT OF HEALTH AND MENTAL HYGIENE

HOWARD COUNTY HEALTH DEPARTMENT
ENVIRONMENTAL HEALTH SERVICES

DISTRICT 4th

P. O. BOX 476, ELLICOTT CITY, MARYLAND 21043
TELEPHONE: 465-5000, EXT. 356

DATE 2/9/73

*Septic tank - 3 bedroom - 1000 gal
H - 1200 gal*

*Dry Well - 138 sq ft absorbent sidewall area per bedroom
to begin below the first 4 ft of non absorbent ground. Max.
depth permitted for dry well is 13 ft below orig. grade.
Place dry well 383 ft from front lot line and
112 ft from right side line as seen when facing
from the front.*

TO: THE COUNTY HEALTH OFFICER

ELLICOTT CITY, MARYLAND

I, HEREBY, APPLY FOR THE NECESSARY TEST IN ORDER TO CONSTRUCT (OR RECONSTRUCT) A SEWAGE DISPOSAL SYSTEM.

PROPERTY OWNER Mordecai Hoseh

Any questions call Louise Adams,
PHONE Pierre Dugan Realty Co.

ADDRESS Woodbine, Maryland

PROPERTY LOCATION:

SUBDIVISION _____ LOT NO. 29A

ROAD AND DESCRIPTION Florence Daisy Road

SIZE OF LOT 5.036 acres TYPE BLDG. 3 or 4 bedrooms

NUMBER OF BEDROOMS

IF NOT SINGLE RESIDENCE DESCRIBE _____

THE SYSTEM INSTALLED UNDER THIS APPLICATION IS ACCEPTABLE ONLY UNTIL PUBLIC FACILITIES BECOME AVAILABLE.

SIGNATURE OF APPLICANT /s/ Louise Adams


APPROVED BY [Signature] FOR Dry Well DATE 2-22-73
(KIND OF SYSTEM)

REJECTED BY _____ FOR _____ DATE _____
(KIND OF SYSTEM)

HOLD PENDING FURTHER TESTS _____ DATE _____

REASONS FOR REJECTION OR HOLDING _____

THIS IS NOT A PERMIT

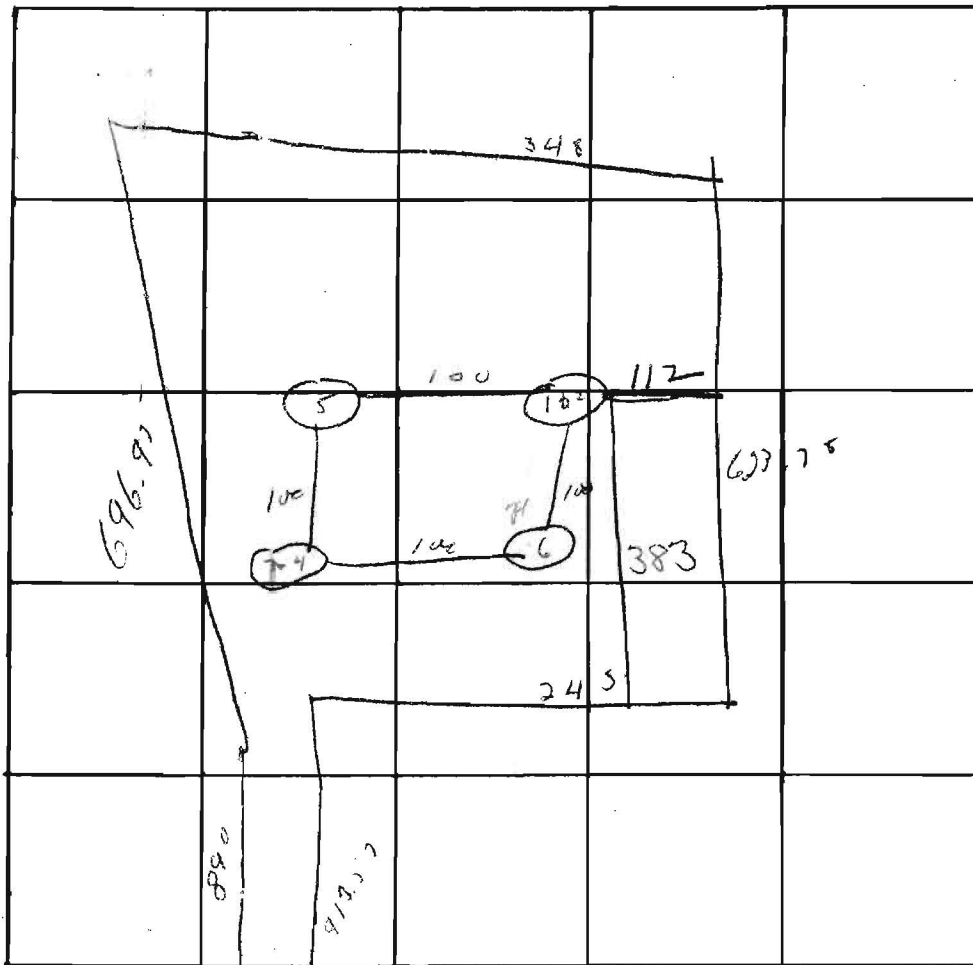

INDICATE NORTH - NAME ADJOINING ROADWAY AS BASE LINE.


Florence R.

DATE	TEST NO.	DEPTH	PRE-WET		TEST - 1" DROP		TIME	
			START	STOP	START	STOP		
2/22/73	1	4 1/2 ft	10 33	10 40	10 40	10 55	15 min	
	2	12 ft	10 33	10 37	10 37	10 47	10 min	
	3	4 1/2 ft	10 35	10 42	10 42	11 00	18 min	
	4	12 ft	10 37	10 40	10 40	10 53	13 min	
	5	not tested - same type soil						
	6	not tested - same type soil						

REMARKS: Oil for depth - 324 lowest

TYPE OF SOIL: _____

TESTED BY: DM ALSO PRESENT: _____

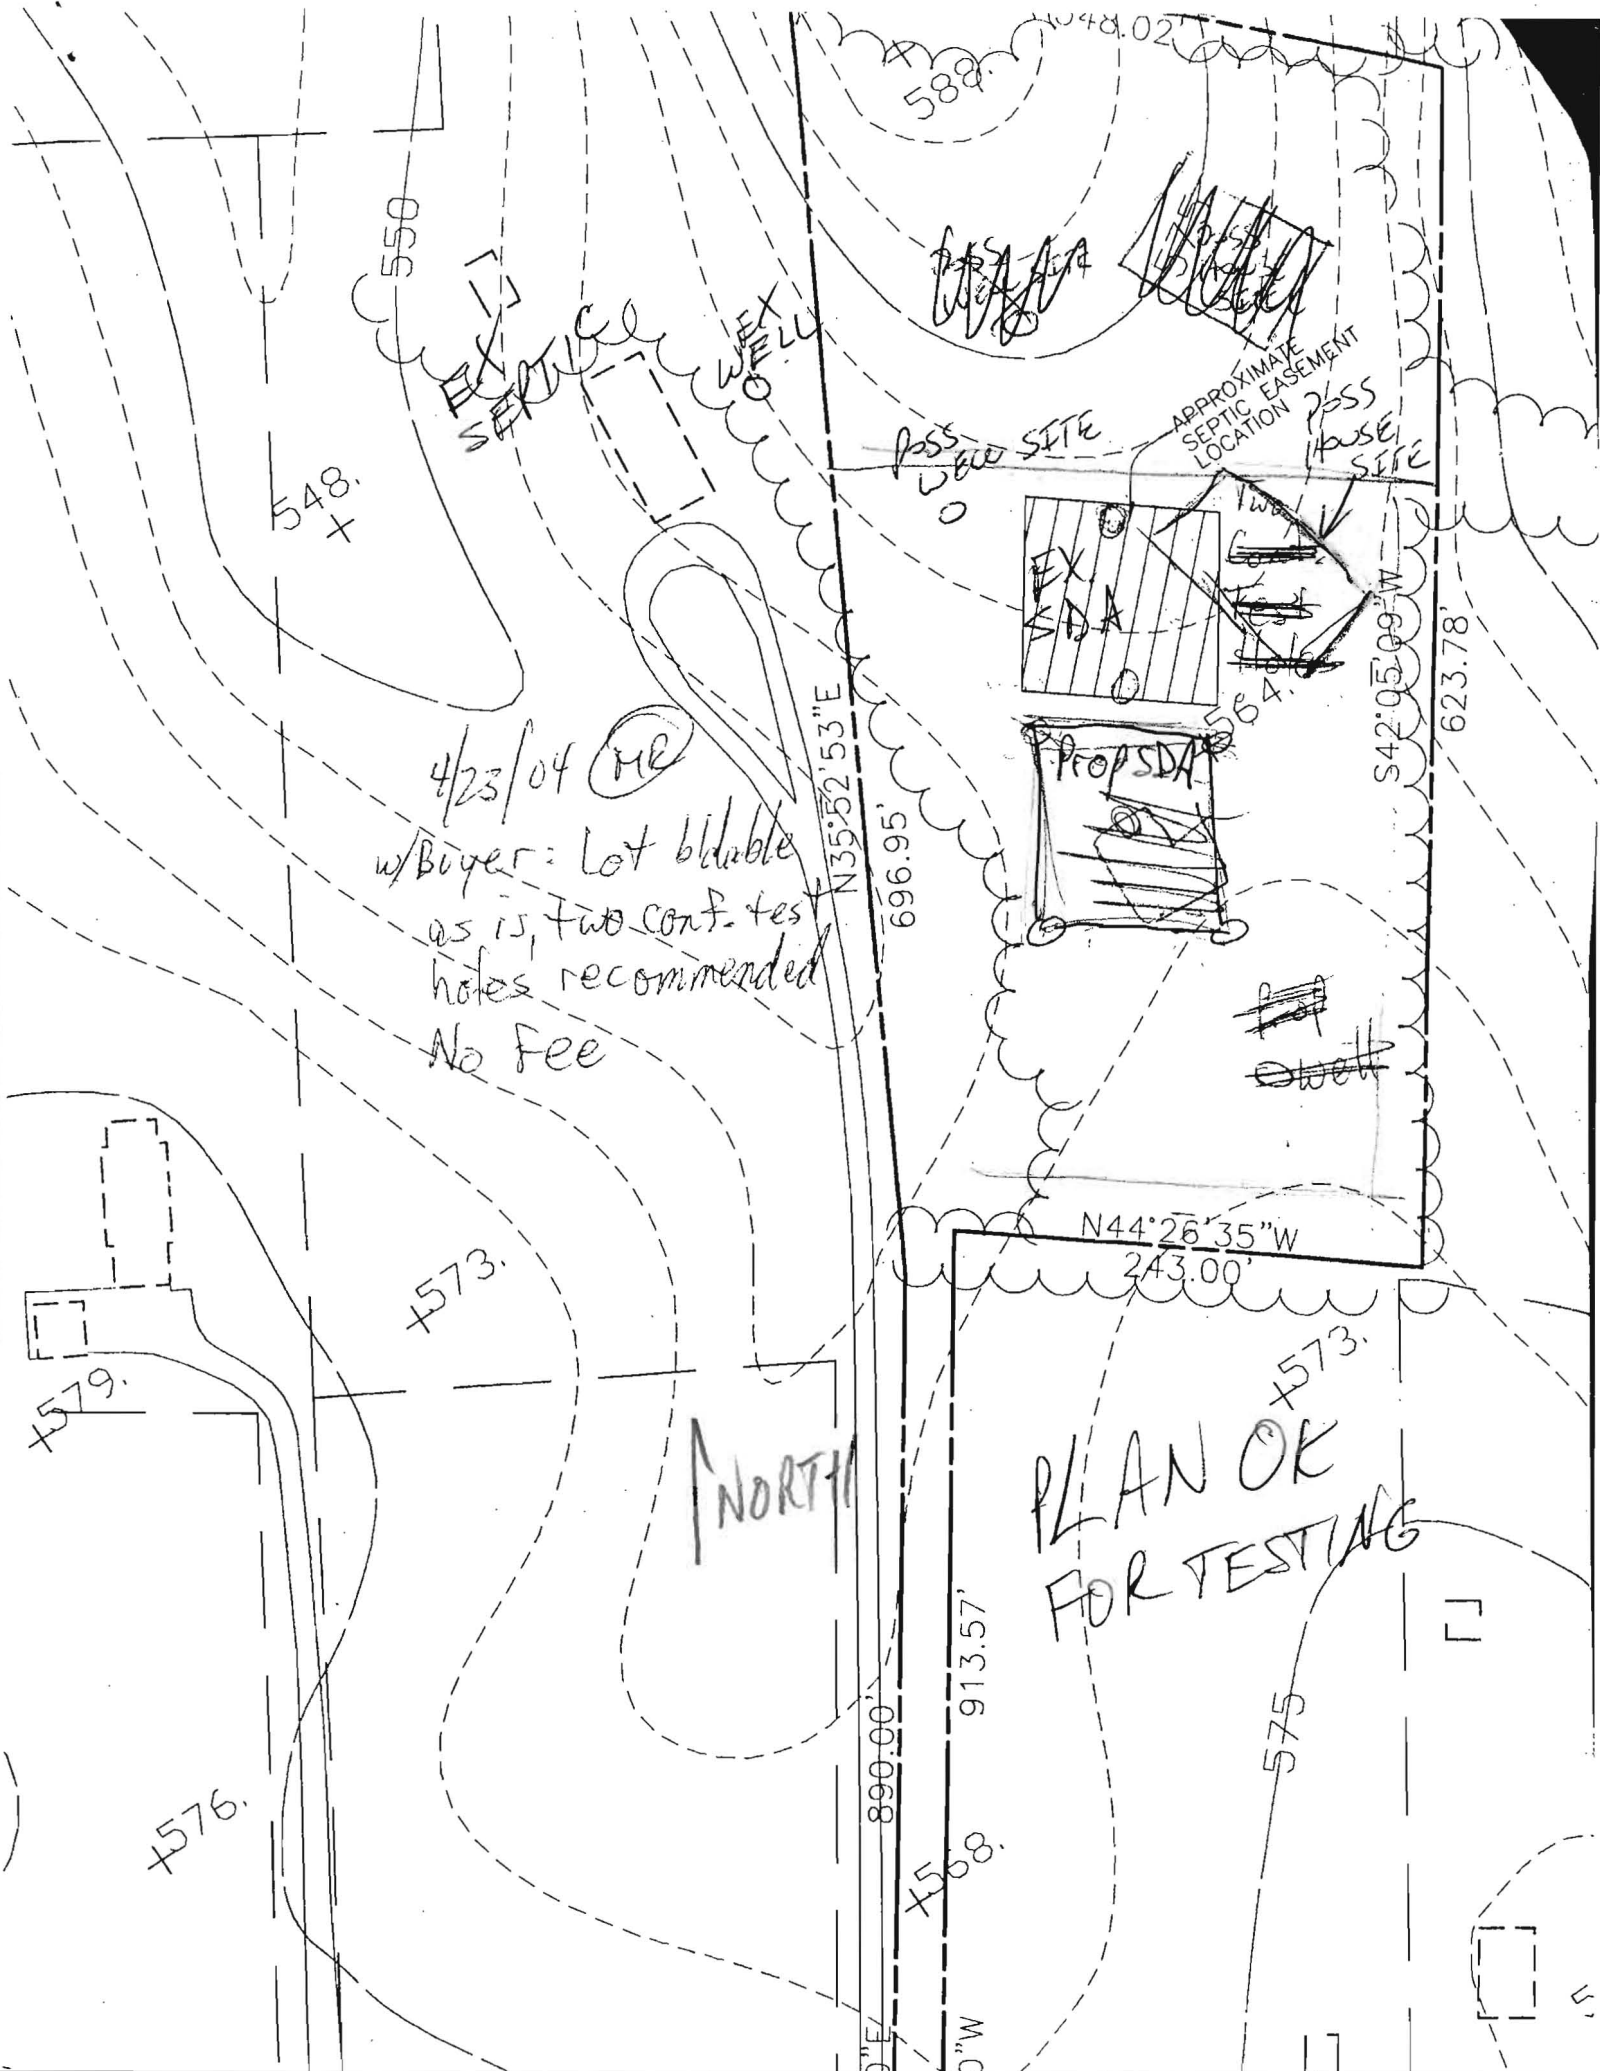

4/23/04 ME
w/ Buyer: Lot bl'dable
as is, Two conf. test
holes recommended
No Fee

PLAN OK
FOR TESTING

588.
548.
550
573.
579.
576.
575.
568.
584.
588.
N44°02'W
APPROXIMATE SEPTIC EASEMENT LOCATION
PASS HOUSE SITE
PASS WELL SITE
EX SDA
Prop SDA
N35°52'53\"E
696.95'
S42°05'09\"W
623.78'
N44°26'35\"W
243.00'
890.00'
913.57'
0\"E
0\"W