

*8/16/65*  
*14/19/65*  
*8/19/65*

# PERMIT

SEWAGE DISPOSAL SYSTEM

P 10568

A 09999

MARYLAND STATE DEPARTMENT OF HEALTH

HOWARD COUNTY

INDEXED

*Incomplete*  
*8/16/65 R.F.*  
*8/19/65 - R.F.*

ELLICOTT CITY

DISTRICT 4

DATE 7/20/65

Coral-Lynn Co.

IS PERMITTED TO INSTALL  ALTER

ADDRESS Finksburg, Maryland

PHONE \_\_\_\_\_

A SEWAGE DISPOSAL SYSTEM LOCATED AT \_\_\_\_\_

SUBDIVISION Poplar Heights

ROAD Hardy Rd.

LOT M

PROPERTY OWNER Dan Boone

ADDRESS \_\_\_\_\_

SPECIFICATIONS - 3 bedrooms

DRAIN FIELD \_\_\_\_\_ DEPTH \_\_\_\_\_ FEET, BOTTOM AREA \_\_\_\_\_ SQ. FT.

SEEPAGE PITS \_\_\_\_\_ ABSORBENT SIDE-WALL AREA \_\_\_\_\_ SQ. FT.

SEPTIC TANK CAPACITY 750 GALLONS

FOR GARBAGE GRINDER, INCREASE DISPOSAL AREA 22% & TANK CAPACITY 50%.

OTHER Dry wells (2) - two 12 ft. diam. by 8 ft. deep below inlet pipe.  
Inlet pipe to be 4 ft. below original grade. \* These specifications must be  
followed exactly.

Locate dry wells 225 ft. from front lot line and in the area between 70 ft.  
to 130 ft. from the left side line as lot is seen when facing it from Hardy  
Rd.


PLANS APPROVED BY R. Fletcher

DATE 5/18/65

FILL SEPTIC TANK AND DISTRIBUTION BOX WITH WATER BEFORE CALLING FOR AN INSPECTION. COVER NO WORK UNTIL INSPECTED AND APPROVED.

NEITHER THE HOWARD COUNTY COMMISSIONERS NOR THE HEALTH DEPARTMENT IS RESPONSIBLE FOR THE SUCCESSFUL OPERATION OF ANY SYSTEM.

A 09999

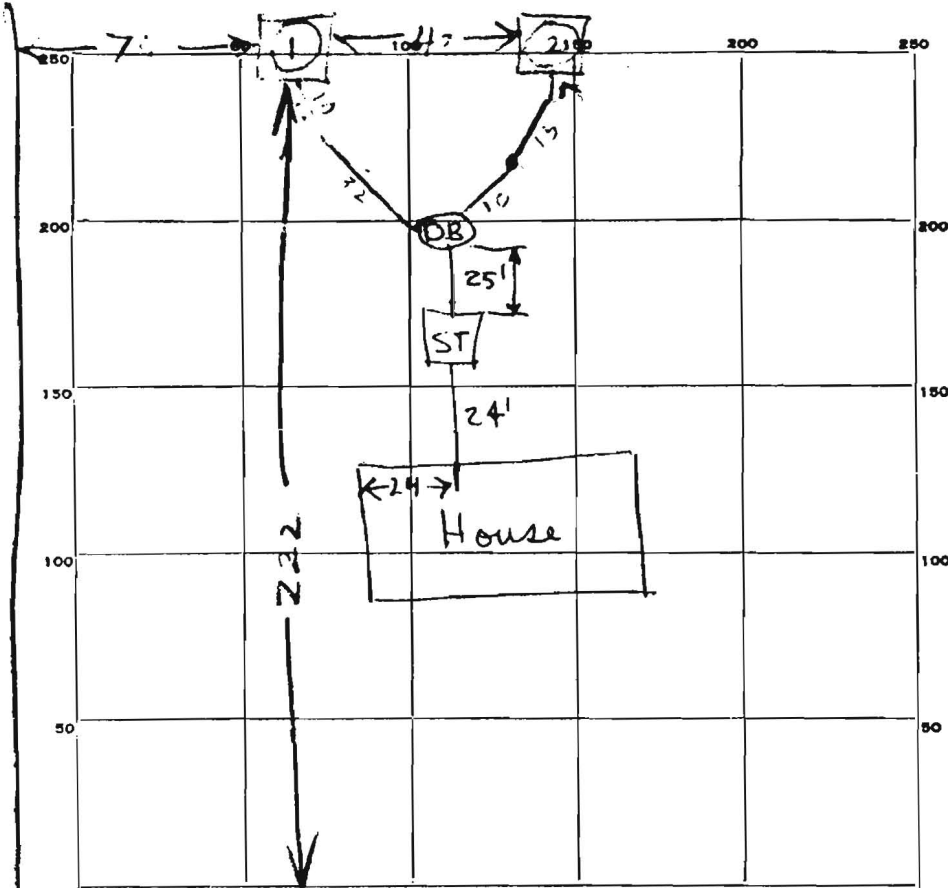

INDICATE NORTH. - NAME ADJOINING ROADWAY AS BASE LINE.

Hardy Rd.

PERMIT CARD \_\_\_\_\_

SEPTIC TANK, LEVEL 21.00  
 DISTRIBUTION BOX, LEVEL \_\_\_\_\_

CLEANOUTS OK

TILE FIELD, DEPTH \_\_\_\_\_ FT. TRENCH WIDTH \_\_\_\_\_ FT.

GRAVEL DEPTH \_\_\_\_\_ IN. TOTAL LENGTH \_\_\_\_\_ FT.

NUMBER OF TRENCHES \_\_\_\_\_ TOTAL BOTTOM AREA \_\_\_\_\_

SEEPAGE PITS, INSIDE DIAMETER \_\_\_\_\_ FT. DEPTH BELOW INLET \_\_\_\_\_ FT.

12 sq ft ABSORBENT AREA 714 SQ. FT. counting stone  
not counting stone

REMARKS Incomplete - 8/6/65 - R.F.  
8/10/65 - Incomplete - R.F. 9/12/65

Well #1 - 3' below grade Depth below inlet 8 FT. Per. to 10 FT  
radius 51 ft. Dist. below grade 4 ft. 7' 1" = 357 counting stone  
at 4' below grade Dist. below inlet 10 FT. Per. to 10 FT  
at 51 ft. Dist. below grade 4 ft. 7' 1" = 357 counting stone

DATE SYSTEM APPROVED 9/12/65 INSPECTOR [Signature]

14  
1300  
51

8/12/65