



B0015038
For detached
Storage building
supported by KB's
perc test done on
5/13/04. BP OK
KN

13850
Burntwoods
Rd.

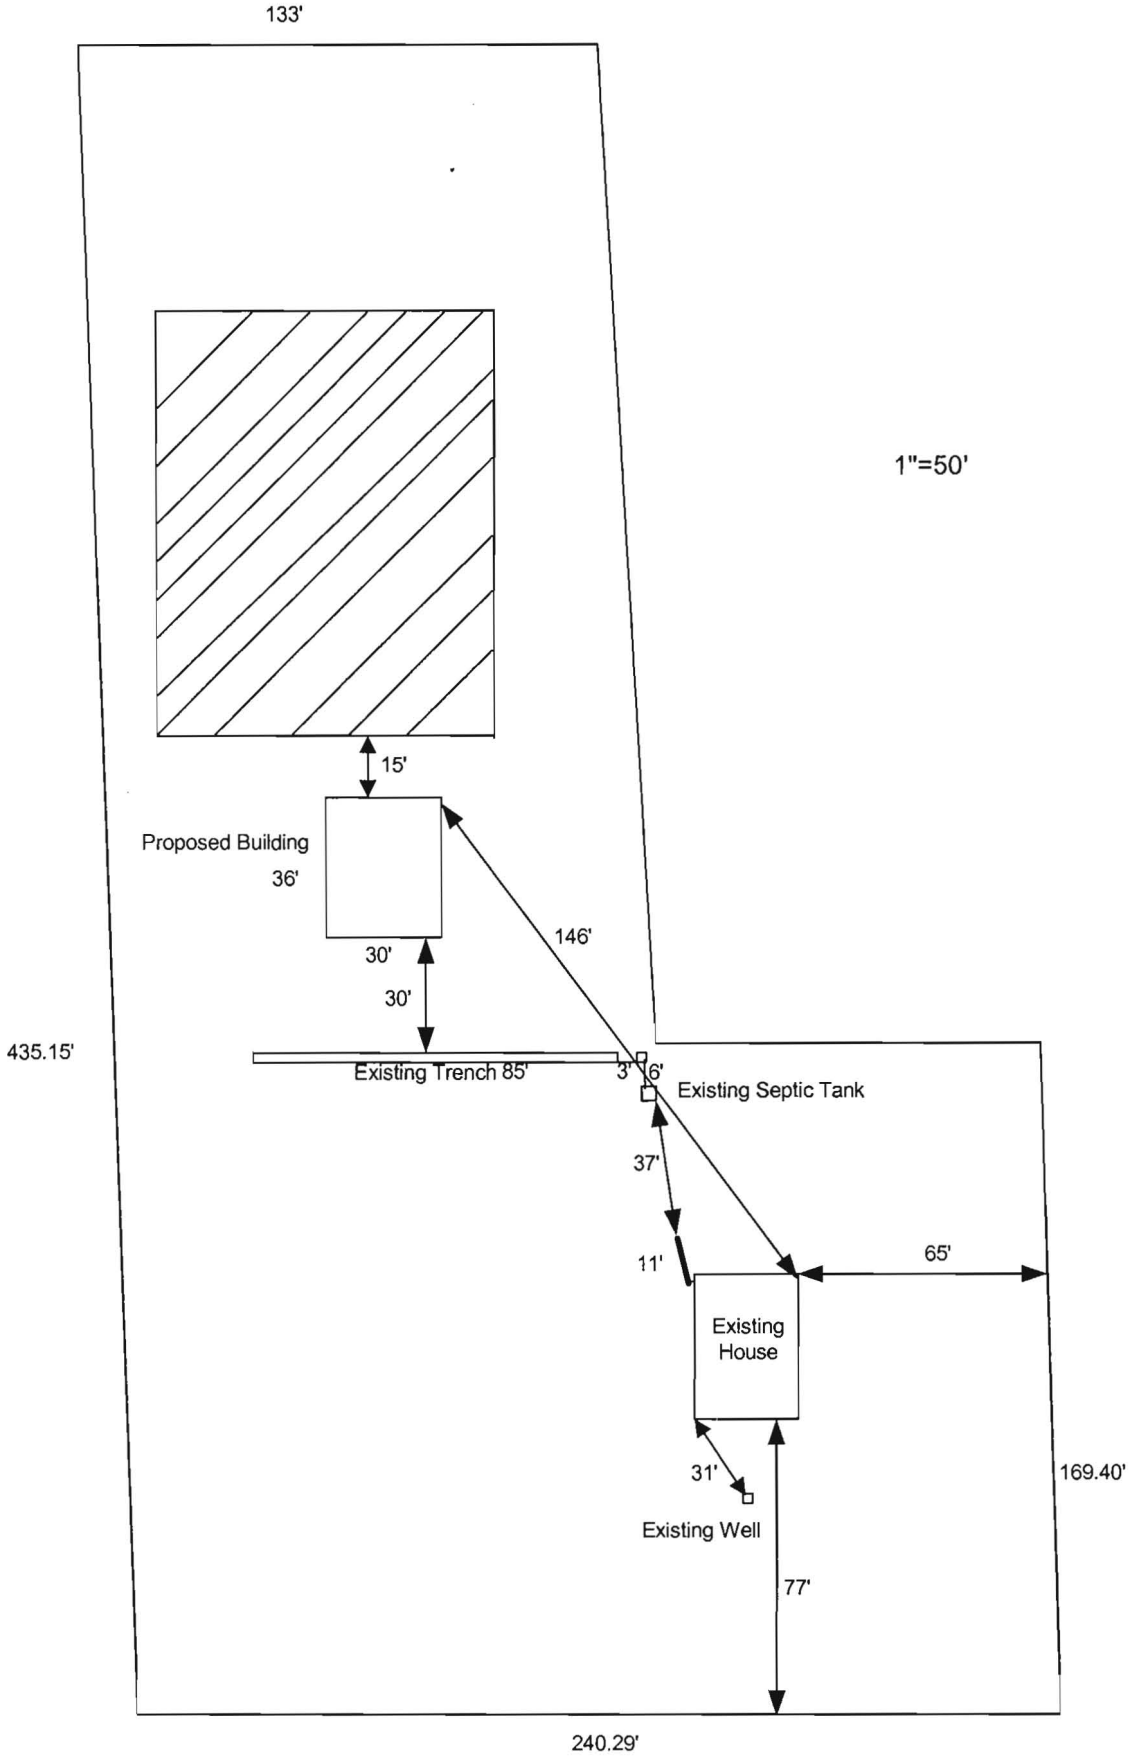

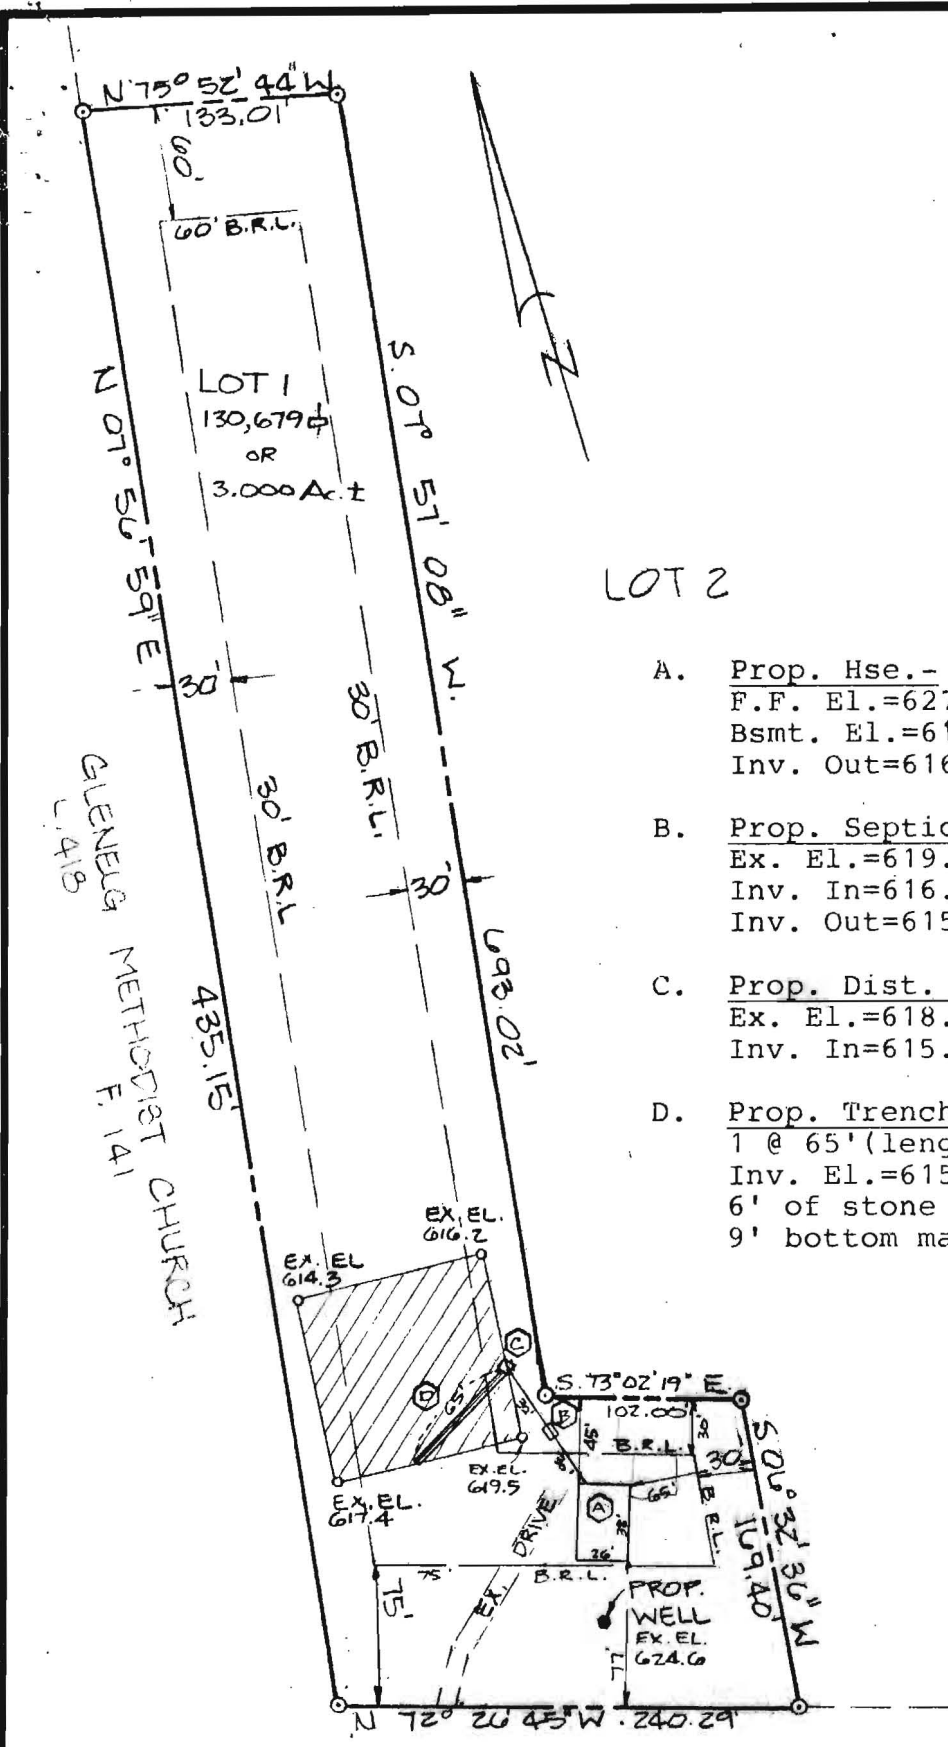

LOT 2

- A. Prop. Hse.-
 F.F. El.=627.0
 Bsmt. El.=618.5
 Inv. Out=616.4
- B. Prop. Septic Tank-
 Ex. El.=619.8
 Inv. In=616.1
 Inv. Out=615.8
- C. Prop. Dist. Box-
 Ex. El.=618.2
 Inv. In=615.5
- D. Prop. Trench-
 1 @ 65' (length)
 Inv. El.=615.2
 6' of stone
 9' bottom max.

GLENELG METHODIST CHURCH
 F. 141
 L. 418

*10/8
 elevations ok
 SKB*

BURNTWOODS ROAD
 80' R/W

PLOT PLAN
 LOT 1, SECTION ONE
 CHRISTIAN L. SMITH
 SUBDIVISION

SITUATED ON BURNTWOODS RD
 THIRD ELECTION DISTRICT
 HOWARD COUNTY, MARYLAND
 SCALE=1"=100' SEPT., 1987



I CERTIFY THIS PLAT TO BE CORRECT; IT IS THE RESULT OF AN ACTUAL FIELD SURVEY, BASED ON DATA FOUND AMONG THE LAND RECORDS OF HOWARD COUNTY, MARYLAND, AS REFERENCED HEREON.



SHELADIA Associates, Inc.
CONSULTING ENGINEERS
 310 A South Main Street, Mt. Airy MD. 21771
 (301) 529-2890

REFERENCE	JOB NO.
	87-1484