


A-27561

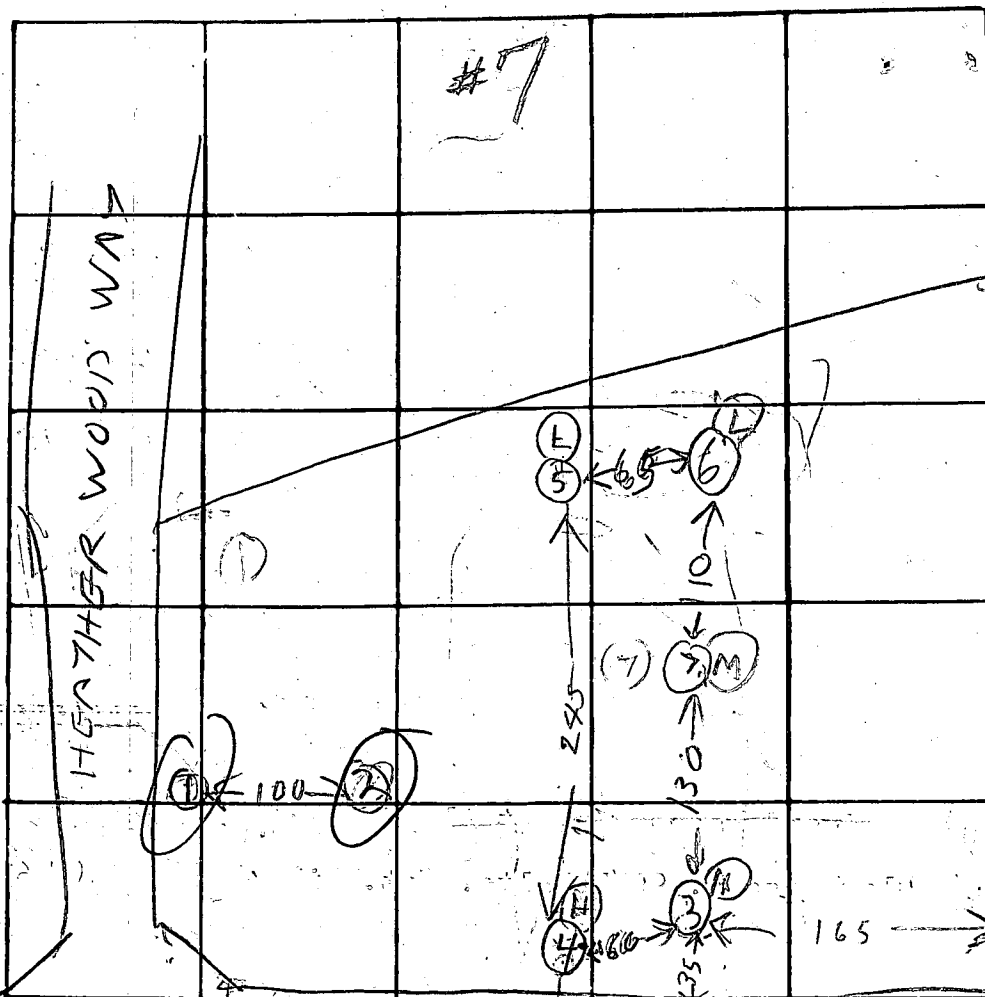

24 0'  
6 0'  
144 0.0

INDICATE NORTH - NAME ADJOINING ROADWAY AS BASE LINE  
OLD FREDERICK RD

| DATE    | TEST NO. | DEPTH | PRE-WET            |                | TEST - 1" DROP |      | TIME | HOLE ELEVATION |
|---------|----------|-------|--------------------|----------------|----------------|------|------|----------------|
|         |          |       | START              | STOP           | START          | STOP |      |                |
| 2/20/78 | (1W)     | 8     | UNDER GROUND WATER |                | 7 FT           |      |      | VERY LOW       |
| 2/28/78 | (2W)     | 11    | UNDERGROUND WATER  |                | 10 FT          |      |      | VERY LOW       |
|         | 3D       | 13    | 1119               | 1127           | 1127           | 1135 | 8    | HIGH           |
|         | 3S       | 4     | 1120               | 1122           | 1122           | 1124 | 5    |                |
|         | 4S       | 4     | 1159               | 1204           | 1204           | 1213 | 8    |                |
| 2/28/78 | 4D       | 8     | 1159               | 1204           | 1204           | 1213 | 8    | HIGH           |
|         | 5S       | 4     | 142                | 146            | 146            | 154  | 8    |                |
|         | 5D       | 8     | 143                | 146            | 146            | 151  | 5    | LOW            |
|         | 6D       | 8     | 158                | 202            | 202            | 206  | 4    | LOW            |
|         | 6S       | 4     | 159                | 200            | 200            | 203  | 3    |                |
| 2/29/78 | 7V       | 12    | DRY                | TOP 3 FT CLAY  |                |      |      | MEDIUM         |
| REMARKS | 5 EP     | 12    | DRY                | BOT 9 FT SANDY |                |      |      |                |

TYPE OF SOIL: POROUS SOIL

2/28/78 TESTED BY: R.H.

ar 930  
LW 230

ALSO PRESENT: E. ROMMEEGEE  
Kavanaugh  
Barth