

PRELIMINARY

APPLICATION

A 26601

SEWAGE DISPOSAL TESTING

P _____

STATE OF MARYLAND - DEPARTMENT OF HEALTH AND MENTAL HYGIENE

1000 gallons
4th DISTRICT

HOWARD COUNTY HEALTH DEPARTMENT
ENVIRONMENTAL HEALTH SERVICES
P. O. BOX 476, ELLICOTT CITY, MARYLAND 21043
TELEPHONE: 465-5000, EXT. 356

Septic tank { 1-3 Bedrooms
4 Bedrooms } 1250 gallons
DATE 8/16/77

*dry well to have 120 sqft. effective
absorbant sidewall area per bedroom below inlet.
Inlet to be 3 1/2' below original grade and maximum
depth 12'. Location per engineer's plat: (1) 10' off left
property line and 150' from front property line when
facing lot from Barbary Way. (2) Per plan of 12/6/78, as indicated*

TO: THE COUNTY HEALTH OFFICER
ELLICOTT CITY, MARYLAND

*certified by W.E. Dwyer
on sep dry well & trench used - need:
1) 5' earth leeches between
dry well & trench*

I, HEREBY, APPLY FOR THE NECESSARY TEST IN ORDER TO CONSTRUCT (OR RECONSTRUCT) A SEWAGE DISPOSAL SYSTEM.

PROPERTY OWNER Robert Frye & Frank Pearl
J & B Partnership

*2 inspections of trench
before end of the stone in.*

Any questions call

ADDRESS 5632 Stevens Forest Rd., Apt. 254, Columbia 21045 PHONE Ron Carter - 837-0194

PROPERTY LOCATION: 6271 Oakland Road
Sykesville, Md. 21784

795-3115
New # 12

SUBDIVISION Westcliffe Manor LOT NO. 38

ROAD AND DESCRIPTION 13742 Barbary Road
off Underwood Road SHORT DIST

SOUTH OF FORSYTH

SIZE OF LOT 50,000 sq. ft. TYPE BLDG. 3 or 4 bedrooms
NUMBER OF BEDROOMS

IF NOT SINGLE RESIDENCE DESCRIBE _____

THE SYSTEM INSTALLED UNDER THIS APPLICATION IS ACCEPTABLE ONLY UNTIL PUBLIC FACILITIES BECOME AVAILABLE.

SIGNATURE OF APPLICANT /s/ Ron Carter

APPROVED BY C. B. [Signature] FOR dry well & trench DATE 1/13/78
(KIND OF SYSTEM)

REJECTED BY _____ FOR _____ DATE _____
(KIND OF SYSTEM)


HOLD PENDING FURTHER TESTS _____ DATE _____

REASONS FOR REJECTION OR HOLDING _____

**BLDG. PERMIT SIGNED
AND RETURNED 12/14/78**
serial # 38009

THIS IS NOT A PERMIT

Old Field Rd
Foreythe

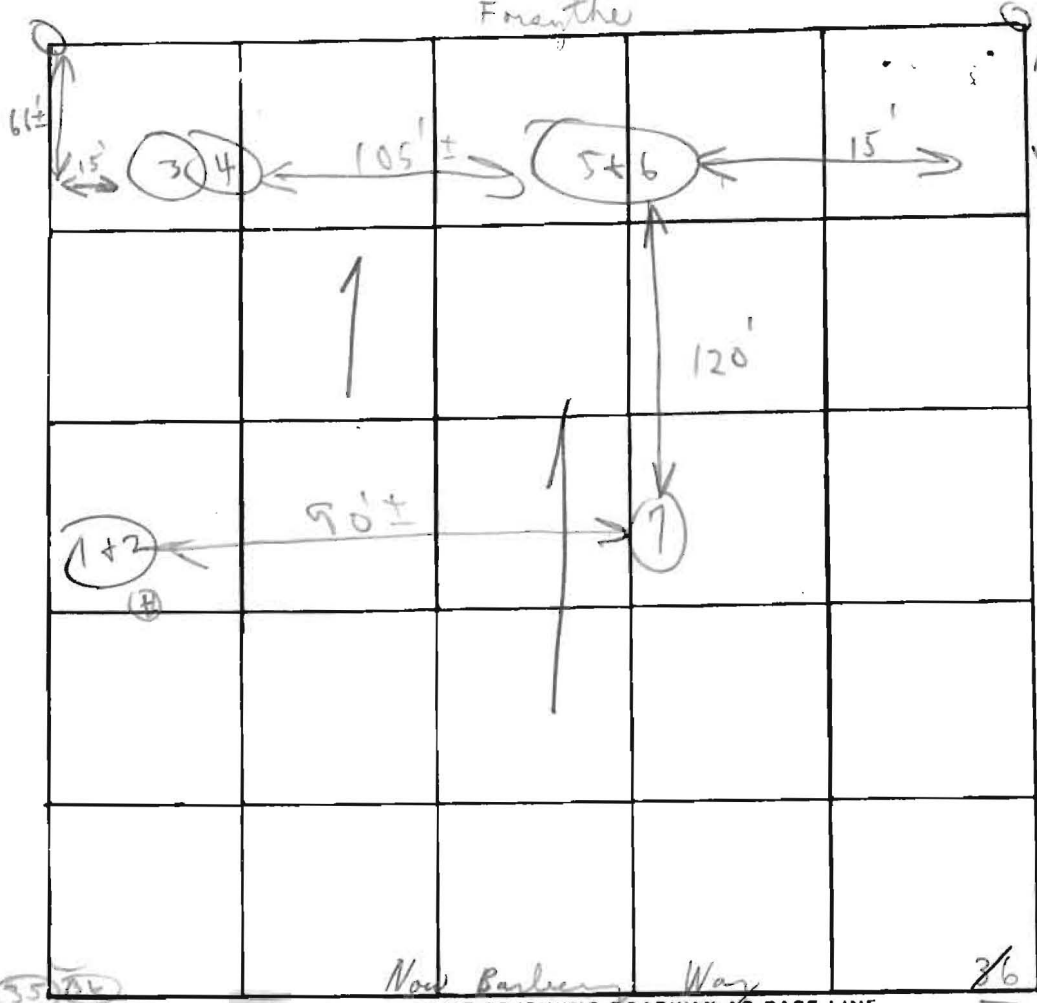

INDICATE NORTH. - NAME ADJOINING ROADWAY AS BASE LINE

Soil Profile
from
below
day
00

DATE	TEST NO.	DEPTH	PRE-WET		TEST - 1" DROP		TIME	
			START	STOP	START	STOP		
8/30/79	1		:	:	4.0 ± 35 ± 11	(1+2) hole	10	
	2		:	:			5	
	3	4 1/2'	11 : 17	11 : 20	11 : 20	11 : 28	8m ±	
	④ 4	13'	11 : 17	11 : 20	11 : 20	11 : 28	8m	
	5	7'	11 : 19	11 : 21	11 : 21	11 : 25	4m	
	④ 6	13'	11 : 17	11 : 22	11 : 22	11 : 26	4m	
	7	12 1/2'	Vertical center to other					1m
							639	

120 ypp.
solid 3 1/2"
6 1/2" good
soil approx
to other

REMARKS Open field
 TYPE OF SOIL _____
 TESTED BY C.B.D. ALSO PRESENT: Fyock etc

12