

Approved 2/2/79 P. C.O. C.B.J.
GLK
6 MAR. 79

PERMIT

SEWAGE DISPOSAL SYSTEM

MARYLAND STATE DEPARTMENT OF HEALTH*

P 29389
A 26601

HOWARD COUNTY

ELLICOTT CITY

DISTRICT 4th

DATE 1/10/79

INDEXED

2/2/79 trench map
2/6/79 final

Robert Frye IS PERMITTED TO INSTALL ALTER

ADDRESS 6271 Oakland Road, Sykesville, Md. 21784 PHONE 795-3115

SUBDIVISION Westcliffe Manor ROAD 13742 Barberrry Way LOT 12

PROPERTY OWNER Robert Frye and Frank Peach

ADDRESS same as above

SPECIFICATIONS 4 bedrooms

SEPTIC TANK CAPACITY 1250 GALLONS

DRAIN FIELD DEPTH FEET, BOTTOM AREA SQ. FT.

DEEP TRENCH DEPTH FEET, BOTTOM AREA SQ. FT.

SEEPAGE PITS ABSORBENT SIDE-WALL AREA 120 SQ. FT. sidewall area per bedroom below inlet.

INLET PIPE 3 1/2 FT. BELOW ORIGINAL GRADE. MAXIMUM DEPTH 12 FT. BELOW ORIGINAL GRADE

EFFECTIVE DEPTH AT FT. BELOW ORIGINAL GRADE

LOCATE DISPOSAL AREA 10 FT. FROM left LOT LINE AND 150 FT. FROM front LOT LINE AS SEEN WHEN

FACING LOT FROM Barberrry Way.

60535

per approved house plans of 12/12/78. C.B.J.

If trench is needed to make up sidewall area needed in system, leave 5 ft. earth buffer between trench and dry well, and run the necessary distance.

PLANS APPROVED BY Charles B. Streaker DATE 1/13/78

COVER NO WORK UNTIL INSPECTED AND APPROVED.

NEITHER THE HOWARD COUNTY COUNCIL NOR THE HEALTH DEPARTMENT IS RESPONSIBLE FOR THE SUCCESSFUL OPERATION OF ANY SYSTEM.

NOTE: IF TRENCH IS USED CALL FOR INSPECTION BEFORE PLACING GRAVEL IN TRENCH.

NOTE: NO DRY WELL SHALL EXCEED 15 FOOT IN DIAMETER.

NOTE: ALL PIPE FROM HOUSE TO DISPOSAL AREA MUST BE CAST IRON.


PERMIT VOID AFTER THREE YEARS.

NOTE: INSTALL STAND PIPE ON SEPTIC TANK AND DRY WELL. STAND PIPES MUST BE 6 INCHES IN DIAMETER. CAST IRON, CONCRETE OR TERRA COTTA ACCEPTED.

*INSTALLER IS RESPONSIBLE FOR OBTAINING FINAL APPROVAL ON THIS PERMIT.

BLDG. PERMITS ISSUED AND REISSUED 4/12/00
Serial # B00123515
Deck w/ steps

A 26601

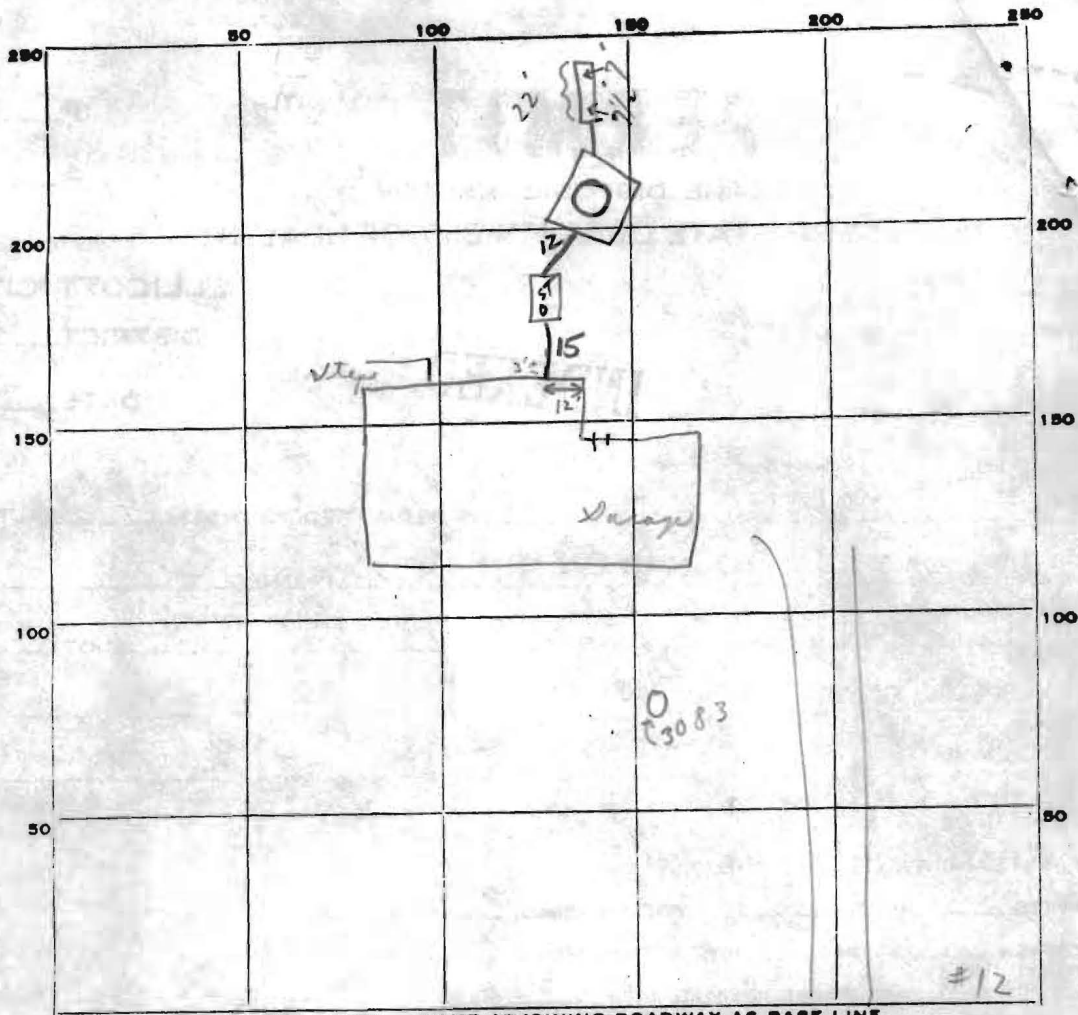

INDICATE NORTH. - NAME ADJOINING ROADWAY AS BASE LINE.

None seen - 316

PERMIT CARD Yes on garage side of Road S.T. D.W.

SEPTIC TANK, LEVEL 1250 Hold CLEANOUTS No No CAST IRON

DISTRIBUTION BOX, LEVEL N/A

TILE FIELD, DEPTH Trench 3/4 7-7 1/2' FT. TRENCH WIDTH 3 FT.

GRAVEL DEPTH 4 IN. TOTAL LENGTH 22' FT.

NUMBER OF TRENCHES 1 TOTAL BOTTOM AREA 88

PRECAST SEEPAGE PITS, INSIDE DIAMETER outside perimeter 48 FT. DEPTH BELOW INLET 8 1/2 FT. 408 new

ABSORBENT AREA ±496 SQ. FT.

REMARKS 2/2/79 checked - notes only 3/4" pipe from house to tank to tank to dig well - Trench only ok for stone.

3/6/79 - Muddy conditions - came in trench on paper pipe. FINAL OK. CLK

DATE SYSTEM APPROVED 6 MAR 79 INSPECTOR George F. Keller