

B 1 0706 SEQUENCE NO. (WRA USE ONLY)

1 2 3 4 (SEQ. NO.) 5 6
 (THIS NUMBER IS TO BE PUNCHED IN COLS. 3-6 ON ALL CARDS)

STATE OF MARYLAND
WATER RESOURCES ADMINISTRATION
TAWES STATE OFFICE BLDG., ANNAPOLIS, MARYLAND 21401
APPLICATION FOR PERMIT TO DRILL WELL

WRA PERMIT NUMBER
HO-73 3083
 FILL IN THIS FORM COMPLETELY

DATE RECEIVED (WRA USE ONLY)
12/1/78
3:00 P.M.

OWNER Eve Robert L. & Peach, Francis T.
 COL 15 LAST NAME FIRST NAME COL. 34

STREET OR RFD 1247 Liberty Road
 COL 36 COL. 55

POST OFFICE Sykesville, Maryland 21784
 COL 57 COL. 76

B 1 CONTINUED DRILLER INFORMATION

1 2 3 (SEQ. NO.) 6

DATE 12/1/78 LICENSE NUMBER 29
77 80

FIRST NAME L. Hyter DRILLER LAST NAME

SIGNATURE [Signature]

B 3 LOCATION OF WELL

1 2 3 (SEQ. NO.) 6

COUNTY Howard (DO NOT ABBREVIATE COUNTY NAME) 21

SUBDIVISION Cliffe Manor 42

SECTION 44 LOT 48 50

NEAREST TOWN Sykesville 71

MILES FROM TOWN (ENTER 0 IF IN TOWN) 73 76 77 78

B 2 WELL INFORMATION

1 2 3 (SEQ. NO.) 6

MAXIMUM PUMPING RATE (GALLONS PER MINUTE) 5-6 8 12

AVERAGE DAILY QUANTITY NEEDED (GALLONS PER DAY) 520 14 20

B 4 DIRECTION FROM TOWN
 (CIRCLE APPROPRIATE BOX)

N NORTH E EAST NE NORTHEAST SE SOUTHEAST

S SOUTH W WEST NW NORTHWEST SW SOUTHWEST

NEAR WHAT ROAD Barberry Way 11 NORTH SOUTH EAST WEST 30

ON WHICH SIDE OF ROAD (CIRCLE APPROPRIATE BOX) N S E W 32 32 32 32

DISTANCE FROM ROAD (ENTER DISTANCE AND CIRCLE APPROPRIATE BOX) 34 37 38 39

USE FOR WATER (CIRCLE APPROPRIATE BOX)

D HOME (SINGLE OR DOUBLE HOUSEHOLD UNIT ONLY)

F FARMING, AGRICULTURE, IRRIGATION

I INDUSTRIAL, COMMERCIAL, STATE AND FEDERAL GOVERNMENT.

M MUNICIPAL WATER SUPPLY } MUST HAVE STATE HEALTH DEPT. APPROVAL

P PRIVATE WATER COMPANY }

T TEST

DRAW A SKETCH BELOW SHOWING LOCATION OF WELL IN RELATION TO NEARBY TOWNS, ROADS AND STREAMS WITH NORTH IN THE DIRECTION OF THE ARROW, AND GIVE DISTANCE FROM WELL TO NEAREST ROAD JUNCTION OR STREAM CROSSING SHOWN ON THE SKETCH. ALSO SHOW, BY MEANS OF AN "X", THE WELL LOCATION IN THE BOX BELOW AND THE BOX NUMBER FROM THE WELL LOCATION MAP.

APPROXIMATE DEPTH OF WELL 173' 24 28 FEET

APPROXIMATE DIAMETER OF WELL 6" (NEAREST INCH)

METHOD OF DRILLING USED (CIRCLE APPROPRIATE METHOD)

BORED (OR AUGERED) JETTED DRIVEN

30-37 AIR-ROTARY AIR-PERCUSSION ROTARY (HYDRAULIC ROTARY)

CABLE REVERSE-ROTARY DRIVE-POINT

OTHER (DESCRIBE) _____


REPLACEMENT OR DEEPEINED WELLS (CIRCLE APPROPRIATE BOX)

N THIS WELL WILL NOT REPLACE AN EXISTING WELL

Y THIS WELL WILL REPLACE A WELL THAT WILL BE ABANDONED AND SEALED

S THIS WELL WILL REPLACE A WELL THAT WILL BE USED AS A STANDBY

D THIS WELL WILL DEEPEIN AN EXISTING WELL PERMIT NUMBER OF WELL TO BE REPLACED OR DEEPEINED (IF AVAILABLE)

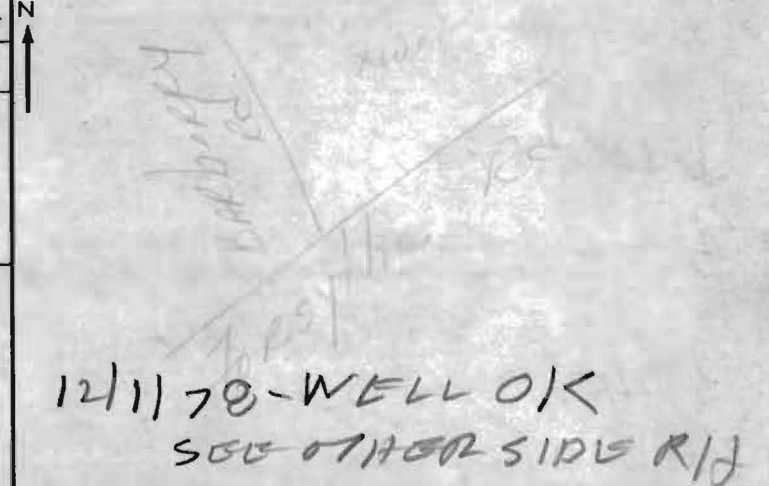

NOT TO BE FILLED IN BY DRILLER (WRA USE ONLY)

APPROPRIATION PERMIT NUMBER 54 ENGINEER REVIEW DISTRICT NO. 65

FORCE 67 WRITE INITIALS IN BOX 68 CONDITIONS 70 71 72 73 74 75 76 77 78 79

BOX NUMBER 800 550

NORTH COORDINATE 50 51 52 53 54 55

EAST COORDINATE 57 58 59 60 61 62 63

ELEVATION AT WELL HEAD (FEET) 65 66 67 68

B 4 CONTINUED HEALTH DEPARTMENT APPROVAL

1 2 3 (SEQ. NO.) 6

41 STATE HEALTH (CIRCLE BOX) COUNTY NAME Howard COUNTY NO. 1320263

DATE 12/1/78 MO. DAY YR. APPROVED BY [Signature]

B 5 SPECIAL CONDITIONS 8-63 (WRA USE ONLY)

1 2 3 (SEQ. NO.) 6

A 26601

(P7)

(P7)

P7 = PERC
TEST

RECEIVED
MAY 30 1978
HOWARD COUNTY
HEALTH DEPT
ELICOTT CITY, MD

(W)

55

SIDE

60

BARBERRY WAY

12/1/78 225 -330



- ① LOCATION OF WELL O.K.
- ② 46 FT CASING WITH 2 1/2 FT OUT OF GROUND
- ③ 43 FT OPEN HOLE
- ④ 20 BAGS
- ⑤ WELL O.K.

RHODGES

William E. Doyle

LAND SURVEYOR 8440

5312 EMERALD DRIVE SYKESVILLE, MARYLAND 21784 PHONE (301) 795-2210

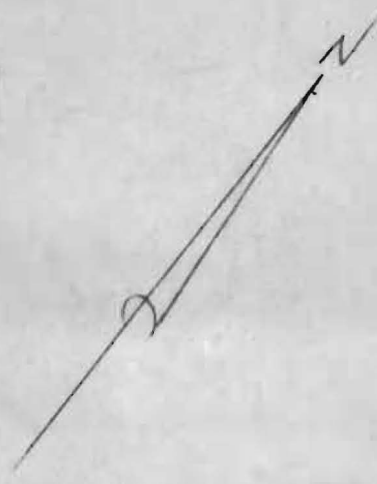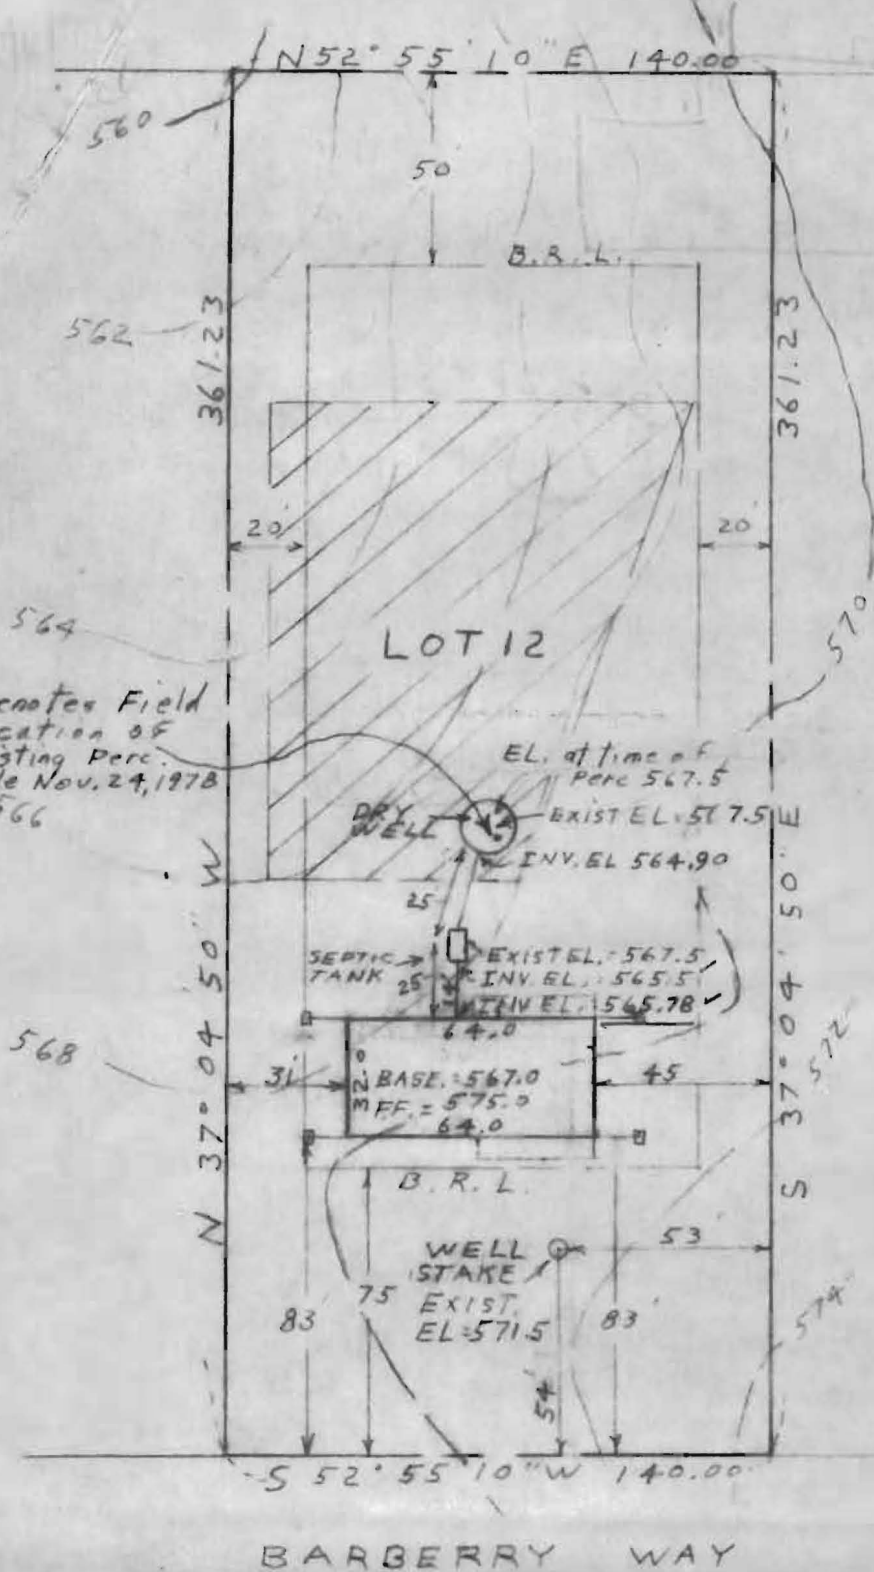

Dist. from septic tank INV 565.5 to Dry Well INV. 564.90 is 30' .02 x 30' = 0.60

B-7 denotes 10' ⊕ Hub set

Robert Foy
795 3115

12/12/78
ok.

C.B.D.

D.



HOUSE STAKEOUT
LOT 12 BARBERRY WAY
WESTCLIFFE MANOR
SHEET 2 OF 2

Election District 4
HOWARD COUNTY MD.

SCALE: 1" = 50'

DRAWN: DEC. 6, 1978

I CERTIFY THE ABOVE MEASUREMENTS AND ELEVATIONS ARE ACTUAL & CORRECT FOR THIS PROPERTY

SIGNED William E. Doyle

File No 43-