


N-10130
E-9910

LOT 1

N-10130
E-10080

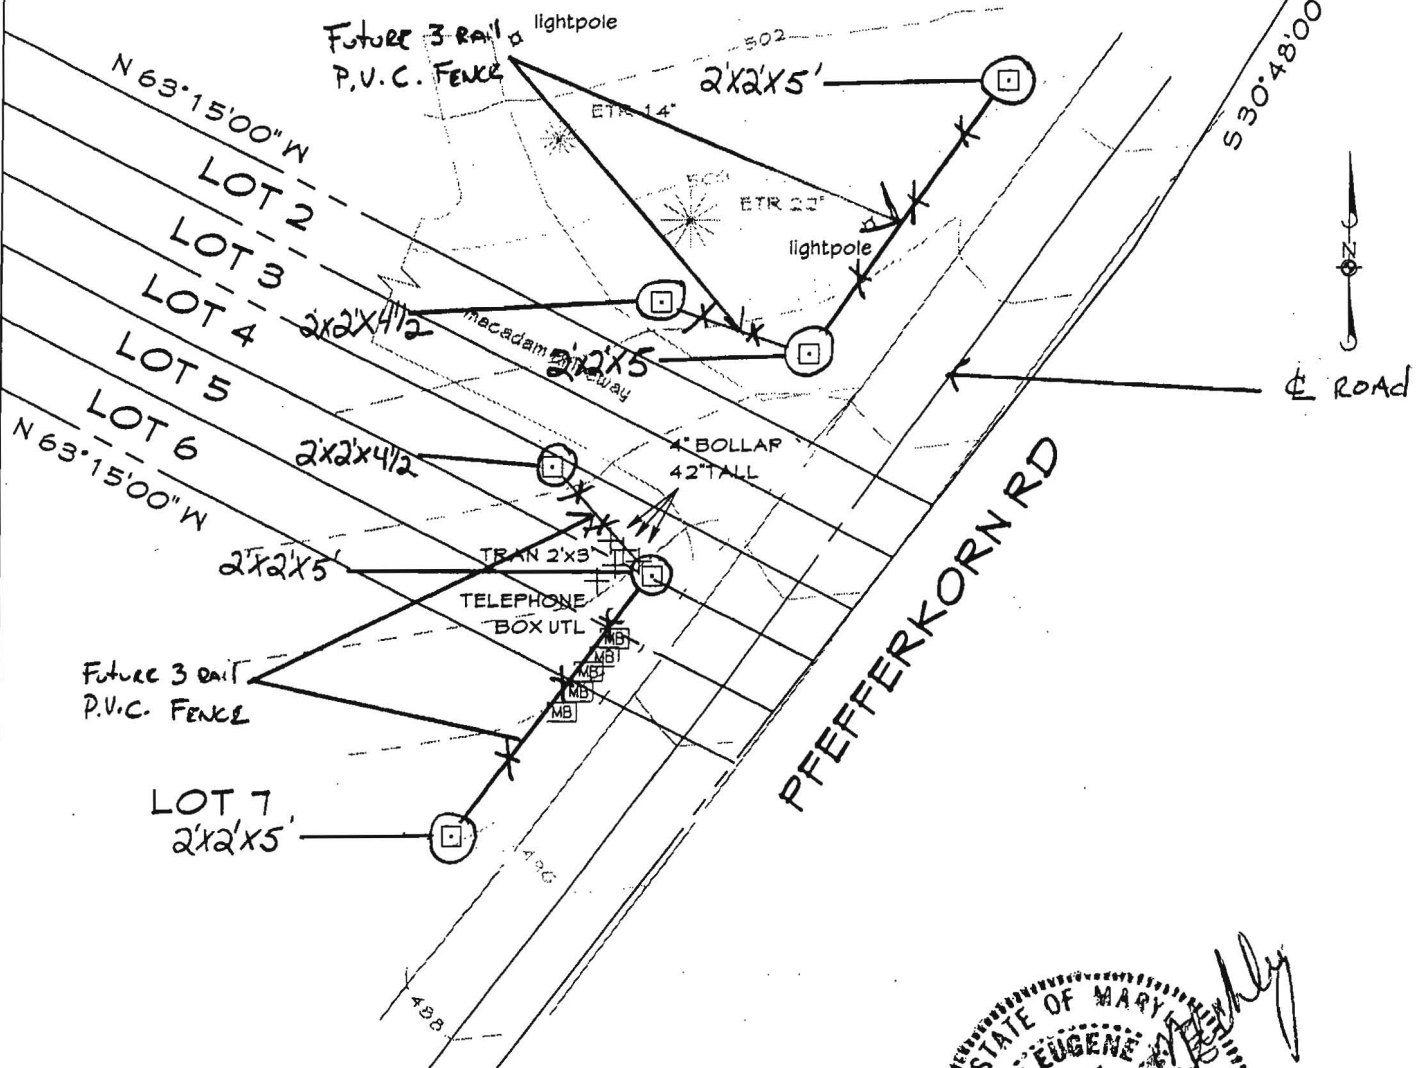

*PO 00146 805 or 3?
3/24/04
Landscape pillars OK
KN*

**TOPOGRAPHIC SURVEY OF
ENTRANCE TO LOTS 1-7 OF
KASEMEYER PROPERTY**

N-9860
E-9910

□ 2.2' x 2.2'
STONE PILLAR

<p>Carroll Land Services Incorporated Engineers • Surveyors • Land Development Consultants Landscape Architects • Environmental Specialists 439 East Main Street Westminster, MD 21157-5539 (410) 876-2017 FAX (410) 876-0009</p>	DRAWN BY: JCG
	DESIGN BY:
	REVIEW BY:
	DATE: 1/12/04
	SCALE: 1" = 30'
	JOB NO: 2001119
SHEET:	