


A10334

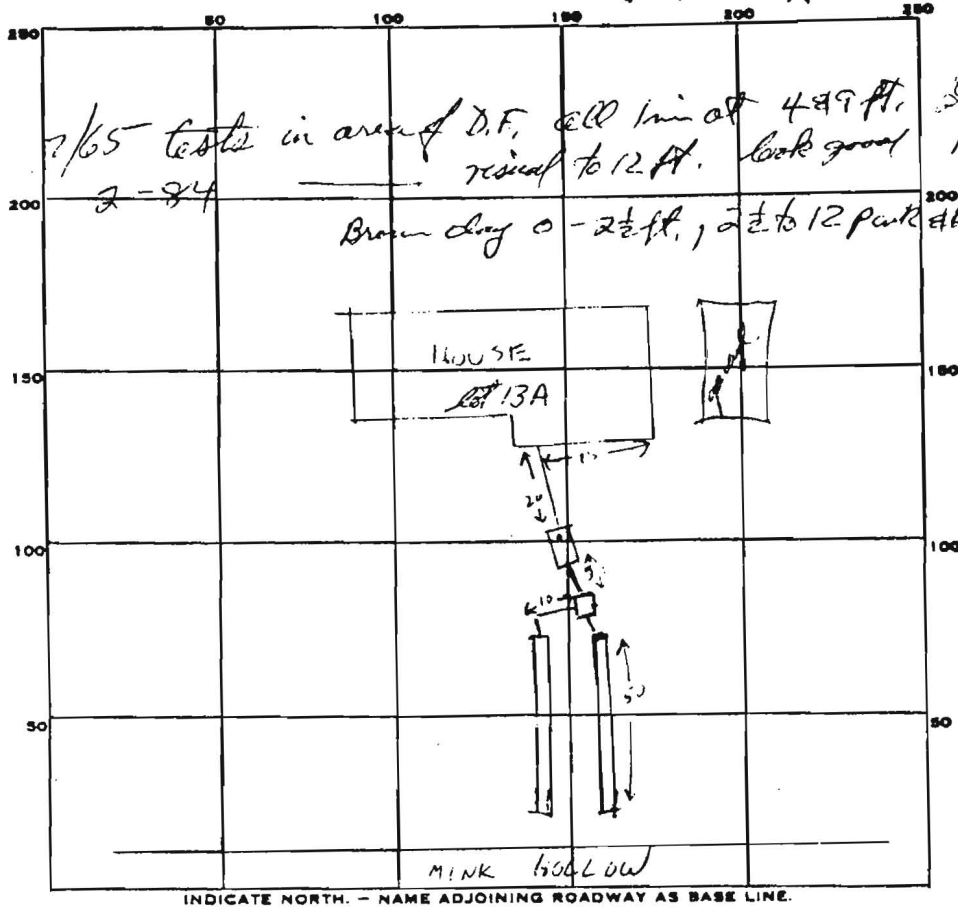

PERMIT CARD

SEPTIC TANK, LEVEL

CLEANOUTS STV

DISTRIBUTION BOX, LEVEL

TILE FIELD, DEPTH 9 FT. TRENCH WIDTH 2 FT.

GRAVEL DEPTH 6 FT IN. TOTAL LENGTH 100 FT.

NUMBER OF TRENCHES 2 (CLASS) ONE S. DRAIN TOTAL BOTTOM AREA \_\_\_\_\_

SEEPAGE PITS, INSIDE DIAMETER \_\_\_\_\_ FT. DEPTH BELOW INLET \_\_\_\_\_ FT.

ABSORBENT AREA 600 SQ. FT.

REMARKS 11/7/89 OK TO ADD 6" TO 12" AREAS. CUL

11/8/89

DATE SYSTEM APPROVED \_\_\_\_\_

INSPECTOR \_\_\_\_\_