

PUB. SEWER STATUS VERIFIED BY _____

ISSUE DATE: _____

APPROVAL DATE: _____

**PERMIT
INDEXED**

P 520408-A

A RE-INDEX

**ON-SITE SEWAGE DISPOSAL SYSTEM
HOWARD COUNTY HEALTH DEPARTMENT
BUREAU OF ENVIRONMENTAL HEALTH**

IS PERMITTED TO INSTALL ALTER

ADDRESS: _____ PHONE NUMBER: _____

SUBDIVISION: Green Henge II LOT NUMBER: 7, Block A

ADDRESS: 2922 Evergreen Way PROPERTY OWNER: Prinn

SEPTIC TANK CAPACITY (GALLONS): _____

PUMP CHAMBER CAPACITY (GALLONS): _____

NUMBER OF BEDROOMS: _____

SQUARE FEET PER BEDROOM: _____

LINEAR FEET OF TRENCH REQUIRED: _____

TRENCHES:	Trench to be _____ feet wide. Inlet _____ feet below original grade. Bottom maximum depth _____ feet below original grade. Effective area begins at _____ feet below original grade. _____ feet of stone below distribution pipe.
LOCATION:	
PURPOSE:	Reindex file 7/30/04

PLANS APPROVED: _____ DATE: _____

- NOTE: PERMIT VOID AFTER 2 YEARS
- NOTE: CONTRACTOR RESPONSIBLE FOR SCHEDULING A PRE-CONSTRUCTION INSPECTION FOR ALL INSTALLATIONS
- NOTE: WATERTIGHT SEPTIC TANKS REQUIRED
- NOTE: ALL PARTS OF SEPTIC SYSTEM SHALL BE 100 FEET FROM ANY WATER WELL
- NOTE: MANHOLE RISERS REQUIRED ON ALL SEPTIC TANKS AND PUMP CHAMBERS

**NEITHER THE HOWARD COUNTY COUNCIL OR THE HEALTH DEPARTMENT IS
RESPONSIBLE FOR THE SUCCESSFUL OPERATION OF ANY SYSTEM
PERMITTEE RESPONSIBLE FOR OBTAINING FINAL APPROVAL ON THIS PERMIT
CALL 410-313-2640 FOR INSPECTION OF SEPTIC SYSTEM**

P520408-A

P520408-A

7/2/66
after 1 PM

PERMIT

SEWAGE DISPOSAL SYSTEM

P. 11642

A. 10413

MARYLAND STATE DEPARTMENT OF HEALTH

HOWARD COUNTY

INDEXED

ELLICOTT CITY

DISTRICT 3

DATE 3/30/66

Hudson Construction Co. IS PERMITTED TO INSTALL ALTER

ADDRESS 363 Chapel Avenue, Ellicott City, Md. PHONE HO 5-2205

A SEWAGE DISPOSAL-SYSTEM LOCATED AT

SUBDIVISION Green Henge ROAD Evergreen Way LOT 7, Blk. A, Sec. 2

PROPERTY OWNER Carvell, Inc.

ADDRESS

SPECIFICATIONS - 4 bedrooms

DRAIN FIELD DEPTH FEET, BOTTOM AREA SQ. FT.

SEEPAGE PITS ABSORBENT SIDE-WALL AREA SQ. FT.

SEPTIC TANK CAPACITY 1,000 GALLONS

FOR GARBAGE GRINDER, INCREASE DISPOSAL AREA 22% & TANK CAPACITY 50%.

OTHER Dry well - 100 sq. ft. absorbent sidewall area below inlet pipe per bedroom. Inlet pipe to be no deeper than 4 ft. below original grade. Locate dry well 75 ft. from front lot line and 60 ft. from right side line as lot is seen when facing it from Evergreen way.


PLANS APPROVED BY P. Fletcher DATE 9/16/65

FILL SEPTIC TANK AND DISTRIBUTION BOX WITH WATER BEFORE CALLING FOR AN INSPECTION. COVER NO WORK UNTIL INSPECTED AND APPROVED.

NEITHER THE HOWARD COUNTY COMMISSIONERS NOR THE HEALTH DEPARTMENT IS RESPONSIBLE FOR THE SUCCESSFUL OPERATION OF ANY SYSTEM.

A
10413
Fletcher

TRIDELPHIA AIN

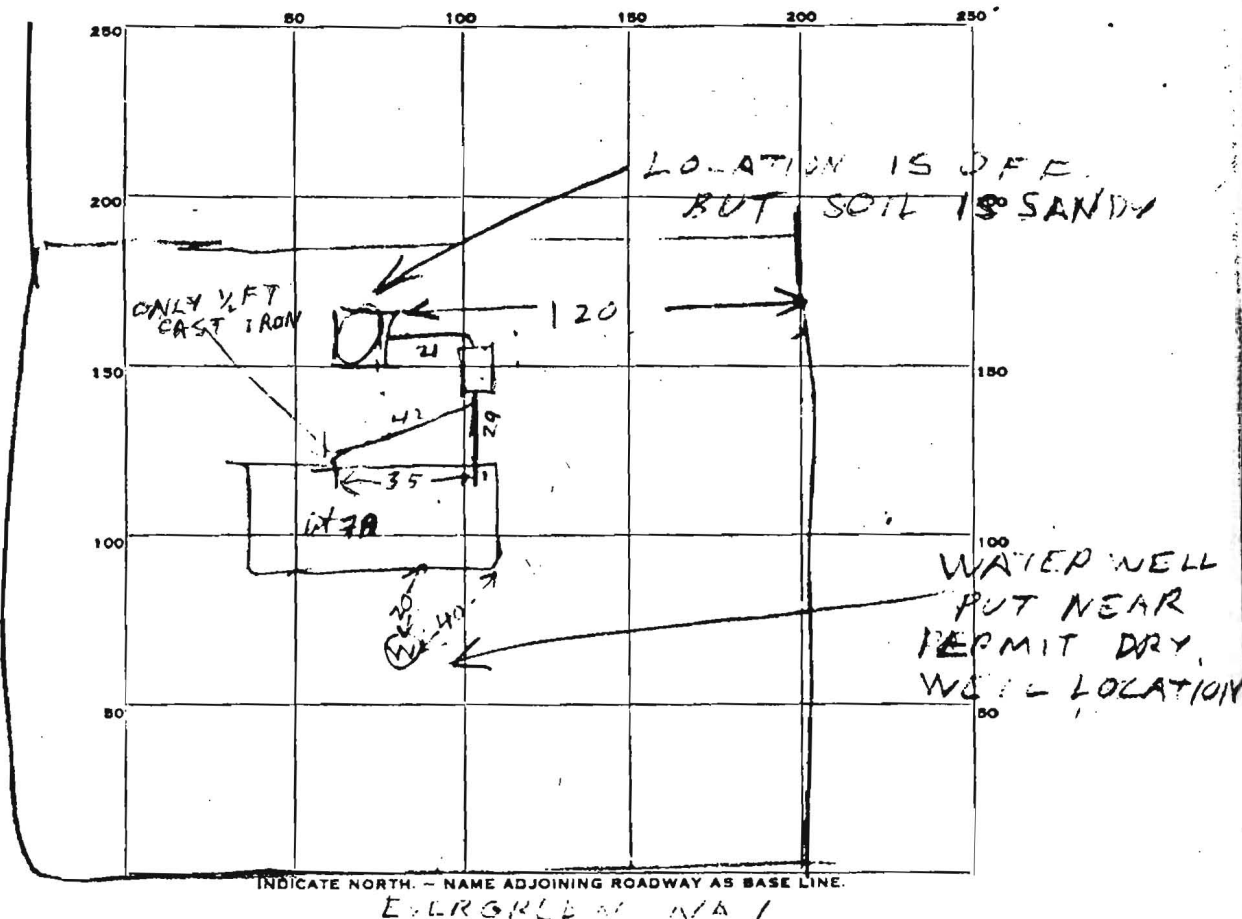

PERMIT CARD

SEPTIC TANK, LEVEL OK 1200 concrete CLEANOUTS OK
 TOP 1 1/2 FT below grade
 DISTRIBUTION BOX, LEVEL _____
 TILE FIELD, DEPTH _____ FT. TRENCH WIDTH _____ FT.
 GRAVEL DEPTH _____ IN. TOTAL LENGTH _____ FT.
 NUMBER OF TRENCHES _____ TOTAL BOTTOM AREA _____
 SEEPAGE PITS, INSIDE DIAMETER 12 FT. DEPTH BELOW INLET 10.5 FT.
 ABSORBENT AREA 33 SQ. FT.

119
125
245
300

REMARKS 7/7/56 - 245 - 12' dia. tank is 4 1/2'
below grade about 1 1/2' from ground
line well trench about 5' apart
with wall around them
with 1/2' cast iron pipe on R side

DATE SYSTEM APPROVED 7/7/56 INSPECTOR [Signature]