

Recorded

Liber 666, Folio 441

# APPLICATION

A 24105

## SEWAGE DISPOSAL TESTING

P \_\_\_\_\_

STATE OF MARYLAND - DEPARTMENT OF HEALTH AND MENTAL HYGIENE

HOWARD COUNTY HEALTH DEPARTMENT  
ENVIRONMENTAL HEALTH SERVICES

DISTRICT 5th

P. O. BOX 476, ELLICOTT CITY, MARYLAND 21043  
TELEPHONE: 465-5000, EXT. 356

DATE 10/1/76

12/8/76

9:30 A.M.

2nd

TO: THE COUNTY HEALTH OFFICER  
ELLICOTT CITY, MARYLAND

I, HEREBY, APPLY FOR THE NECESSARY TEST IN ORDER TO CONSTRUCT (OR RECONSTRUCT) A SEWAGE DISPOSAL SYSTEM.

PROPERTY OWNER Richard G. Allison

ADDRESS 6717 Mink Hollow Rd, Highland, Md. 20777 PHONE 28602333

or call: Richard Hallowell 286-2988

PROPERTY LOCATION: Parcel 12 of tract surveyed by C. Skinner 5/19/72 Individual & master plat attached.

SUBDIVISION \_\_\_\_\_ LOT NO. \_\_\_\_\_

ROAD AND DESCRIPTION Approx. 1/2 mi. S. of Highland Rd on E. side of Mink Hollow Rd - subject property adjoins 6717 Mink Hollow Rd.

SIZE OF LOT 5.886 ac. L666/F441 TYPE BLDG. 4 bedrm single fam. dwg.  
NUMBER OF BEDROOMS \_\_\_\_\_

IF NOT SINGLE RESIDENCE DESCRIBE \_\_\_\_\_

THE SYSTEM INSTALLED UNDER THIS APPLICATION IS ACCEPTABLE ONLY UNTIL PUBLIC FACILITIES BECOME AVAILABLE.

SIGNATURE OF APPLICANT Richard Hallowell  
for Richard G. Allison

APPROVED BY \_\_\_\_\_ FOR \_\_\_\_\_ DATE \_\_\_\_\_  
(KIND OF SYSTEM)

REJECTED BY \_\_\_\_\_ FOR \_\_\_\_\_ DATE \_\_\_\_\_  
(KIND OF SYSTEM)

HOLD PENDING FURTHER TESTS RH & RB DATE 12/8/76

REASONS FOR REJECTION OR HOLDING 12/8/76 - ROCK, TOO MUCH SLOPE & DANGER OF UNDERGROUND WATER RH

# THIS IS NOT A PERMIT


INDICATE NORTH. — NAME ADJOINING ROADWAY AS BASE LINE.

DATE	TEST NO.	DEPTH	PRE-WET		TEST - 1" DROP		TIME
			START	STOP	START	STOP	

REMARKS \_\_\_\_\_

TYPE OF SOIL \_\_\_\_\_

TESTED BY \_\_\_\_\_ ALSO PRESENT: \_\_\_\_\_

# APPLICATION

A 24105

## SEWAGE DISPOSAL TESTING

P \_\_\_\_\_

STATE OF MARYLAND - DEPARTMENT OF HEALTH AND MENTAL HYGIENE

HOWARD COUNTY HEALTH DEPARTMENT  
ENVIRONMENTAL HEALTH SERVICES  
P. O. BOX 476, ELLICOTT CITY, MARYLAND 21043  
TELEPHONE: 465-5000, EXT. 356

DISTRICT 5th  
DATE 10/1/76

TO: THE COUNTY HEALTH OFFICER  
ELLICOTT CITY, MARYLAND

I, HEREBY, APPLY FOR THE NECESSARY TEST IN ORDER TO CONSTRUCT (OR RECONSTRUCT) A SEWAGE DISPOSAL SYSTEM.

PROPERTY OWNER Richard G. Allison

ADDRESS 6717 Mink Hollow Rd, Highland, Md. 20727 PHONE 28602333

PROPERTY LOCATION: or call: Richard Hallowell 286-2988

SUBDIVISION Parcel 12 of tract surveyed by C. Skinner 5/19/72 Individual & master plat attached. LOT NO. \_\_\_\_\_

ROAD AND DESCRIPTION Approx. 1/2 mi. S. of Highland Rd on E. side of Mink Hollow Rd - subject property adjoins 6717 Mink Hollow Rd.

SIZE OF LOT 5.886 ac. L666/F441 TYPE BLDG. 4 bedrm single fam. dwg. NUMBER OF BEDROOMS \_\_\_\_\_

IF NOT SINGLE RESIDENCE DESCRIBE \_\_\_\_\_

THE SYSTEM INSTALLED UNDER THIS APPLICATION IS ACCEPTABLE ONLY UNTIL PUBLIC FACILITIES BECOME AVAILABLE.

SIGNATURE OF APPLICANT Richard Hallowell  
for Richard G. Allison

APPROVED BY \_\_\_\_\_ FOR \_\_\_\_\_ DATE \_\_\_\_\_  
(KIND OF SYSTEM)

REJECTED BY \_\_\_\_\_ FOR \_\_\_\_\_ DATE \_\_\_\_\_  
(KIND OF SYSTEM)


HOLD PENDING FURTHER TESTS \_\_\_\_\_ DATE \_\_\_\_\_

REASONS FOR REJECTION OR HOLDING \_\_\_\_\_

# THIS IS NOT A PERMIT

952°47'28E

160

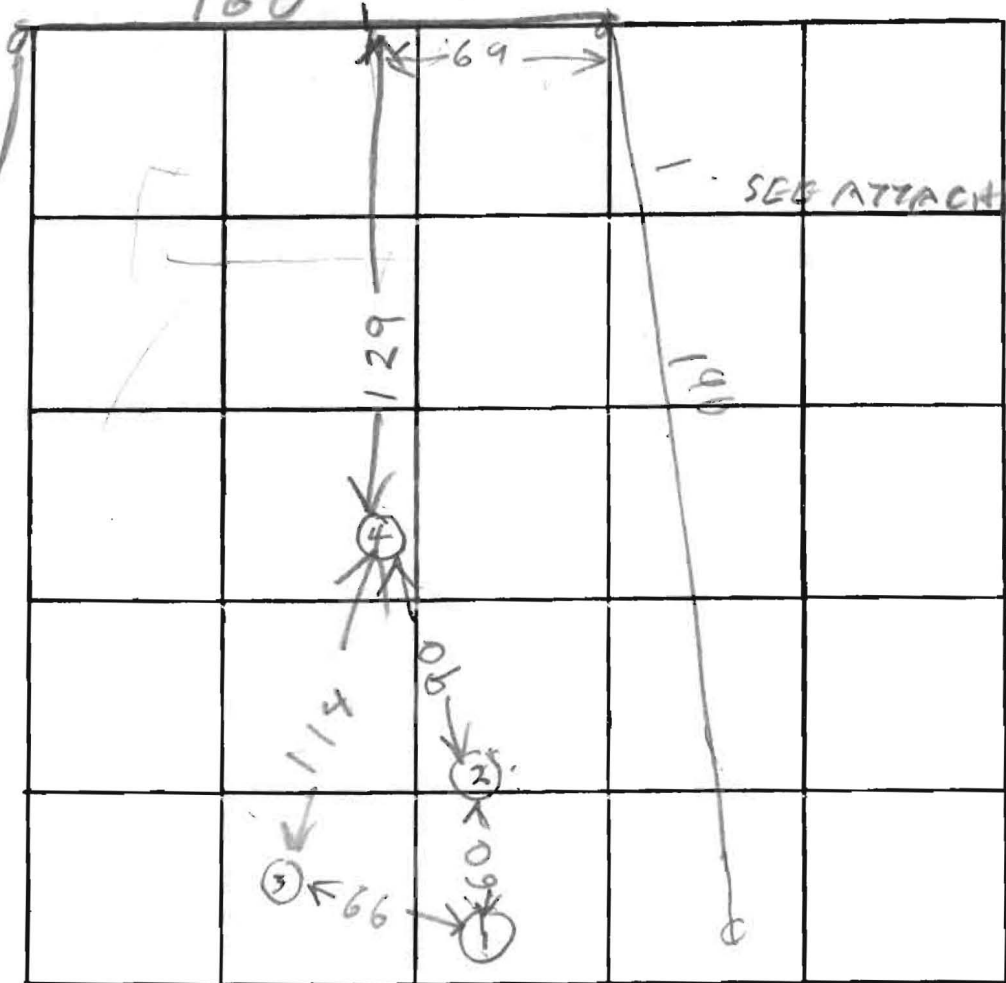

INDICATE NORTH. - NAME ADJOINING ROADWAY AS BASE LINE.

DATE	TEST NO.	DEPTH	PRE-WET		TEST - 1" DROP		TIME
			START	STOP	START	STOP	
12/8/76	1	4	TOP 3 FT CLAY	ROCK BOTTOM			
	2	11	TOP 3 FT CLAY MID 8 FT SANDY	ROCK BOTTOM			
	3	2 1/2	TOP 3 FT CLAY MID 6 1/2 SANDY	ROCK BOTTOM			
	4	8	TOP 4 FT CLAY MID 4' SANDY	BOTTOM ROCK			
	5						

HOLE ELEVATION


LOWEST  
NEXT LOW  
SAME AS 2  
HIGHEST

REMARKS SOME PARTS OF LOT IN FLOOD PLAIN /  
SOME PARTS HAVE 25% SLOPE

TYPE OF SOIL \_\_\_\_\_

TESTED BY RHC RB

J. FYOLK  
ALSO PRESENT: MARIGENE ALLISON

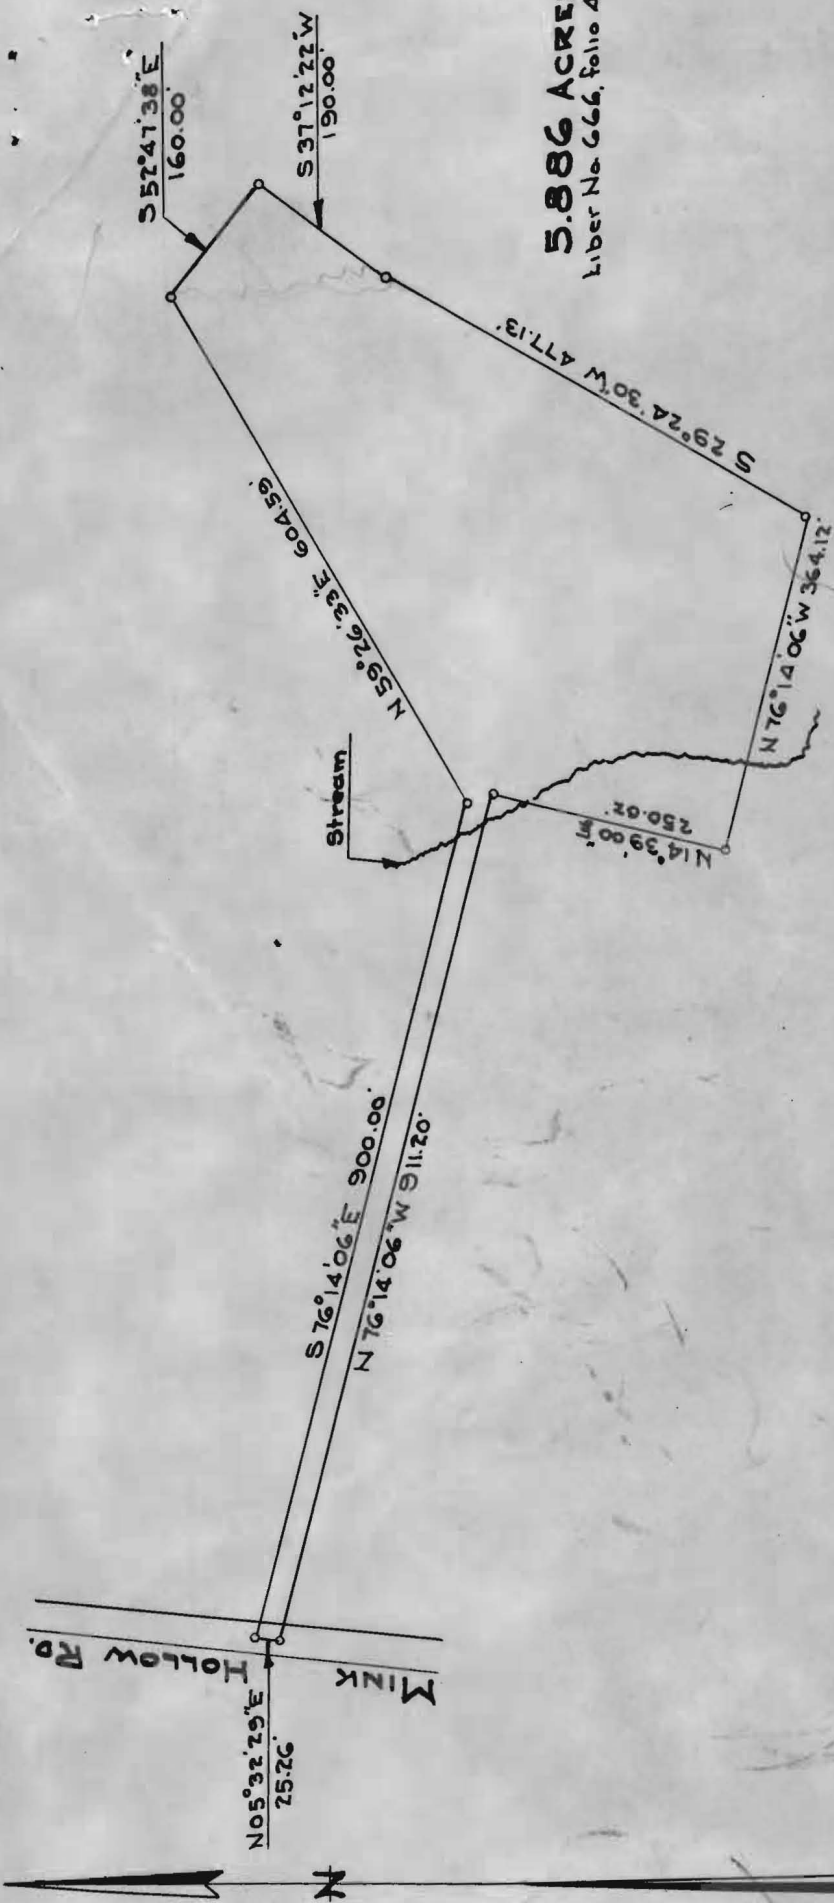

**5.886 ACRES**  
 Liber No 666, folio 441

**PLAT FROM DEED  
 FOR**

**RICHARD G. ALLISON**  
**FIFTH ELECTION DIST., HOWARD COUNTY,**  
**HIGHLAND, MARYLAND.**

**SCALE: 1 IN. = 200 FT., SEPT. 22, 1976**



*James M. [Signature]*  
 A-4021

Note: The lot shown hereon complies with the minimum ownership and lot area as required by the Maryland State Health Department.

Approved: Private Water and Private Sewer

\_\_\_\_\_  
 Howard County Health Officer      Date