

# APPLICATION

SEWAGE DISPOSAL TESTING

A 15711

P \_\_\_\_\_

MARYLAND STATE DEPARTMENT OF HEALTH

HOWARD COUNTY

ELLICOTT CITY

DISTRICT 4th

DATE 2-3-71

TO THE COUNTY HEALTH OFFICER  
ELLICOTT CITY, MARYLAND

I, HEREBY, APPLY FOR THE NECESSARY TESTS IN ORDER TO CONSTRUCT (OR RECONSTRUCT) A SEWAGE DISPOSAL SYSTEM.

PROPERTY OWNER Clarence E. Bassler

ADDRESS Daisy Rd., Woodbine, Md. PHONE 489-1161

PROPERTY LOCATION:

SUBDIVISION DAY 7 MEADOWS LOT NO 7

ROAD AND DESCRIPTION Daisy Rd., Lisbon, Md.

OCCUPANT \_\_\_\_\_ PHONE \_\_\_\_\_

PERSON TO CONSTRUCT SYSTEM \_\_\_\_\_

ADDRESS \_\_\_\_\_ PHONE \_\_\_\_\_

SIZE OF LOT 1.0 acre TYPE BLDG 3 of 4 Bedrooms  
NUMBER OF BEDROOMS

IF NOT SINGLE RESIDENCE DESCRIBE \_\_\_\_\_

SIGNATURE OF APPLICANT Clarence E. Bassler et al


APPROVED BY \_\_\_\_\_ FOR \_\_\_\_\_ DATE \_\_\_\_\_  
(KIND OF SYSTEM)

REJECTED BY \_\_\_\_\_ FOR \_\_\_\_\_ DATE \_\_\_\_\_  
(KIND OF SYSTEM)

HOLD PENDING FURTHER TESTS \_\_\_\_\_ DATE \_\_\_\_\_

REASONS FOR REJECTION OR HOLDING \_\_\_\_\_

11-19-64  
 8  
 HOW. DEPT.  
 TULLOCH, W. W.

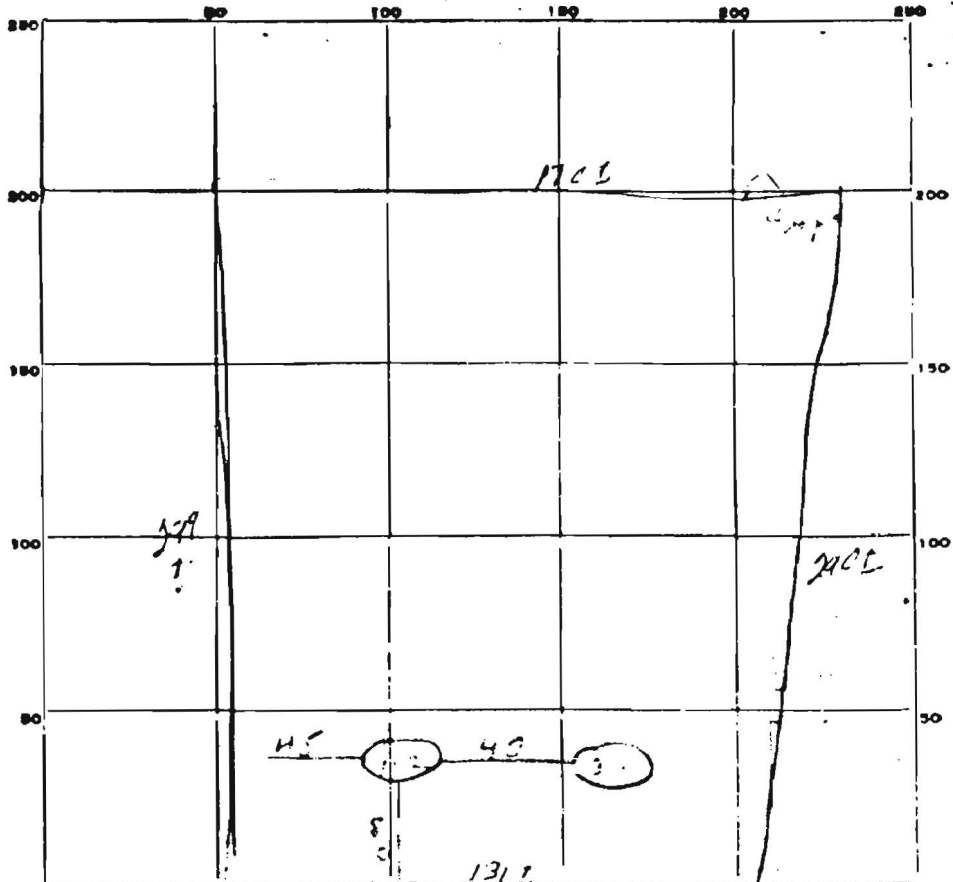

INDICATE NORTH. - NAME ADJOINING ROADWAY AS BASE-LINE

DATE	TEST NO.	DEPTH	PRE-WET		TEST - 1" DROP		TIME
			START	STOP	START	STOP	
5-24-76	1	4 ft	06	11	11	18	7 min
	2	12 ft	12	19	19	27	14 min
	3	14 ft	20	22	22	27	9 min
	4	12 ft	23	27	28	27	14 min

115 min

SOIL AUGER FINDING 51-5-4