



A15711

298.76'

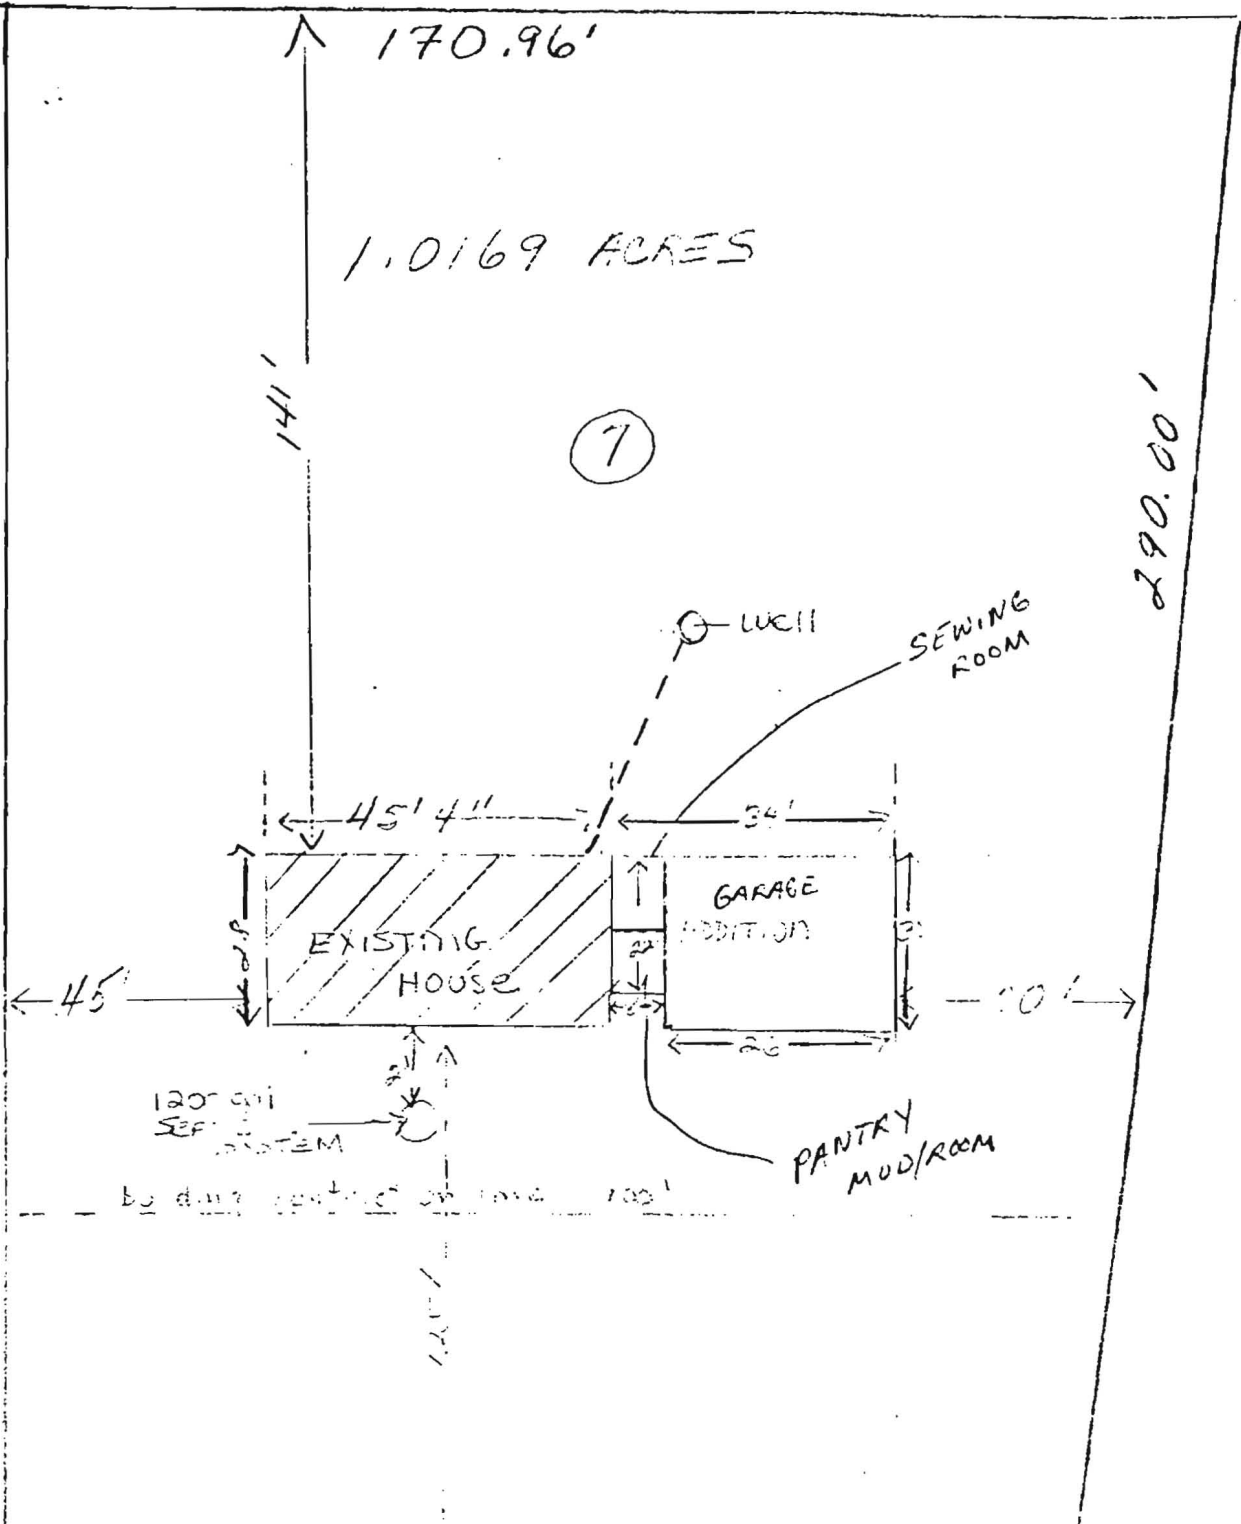

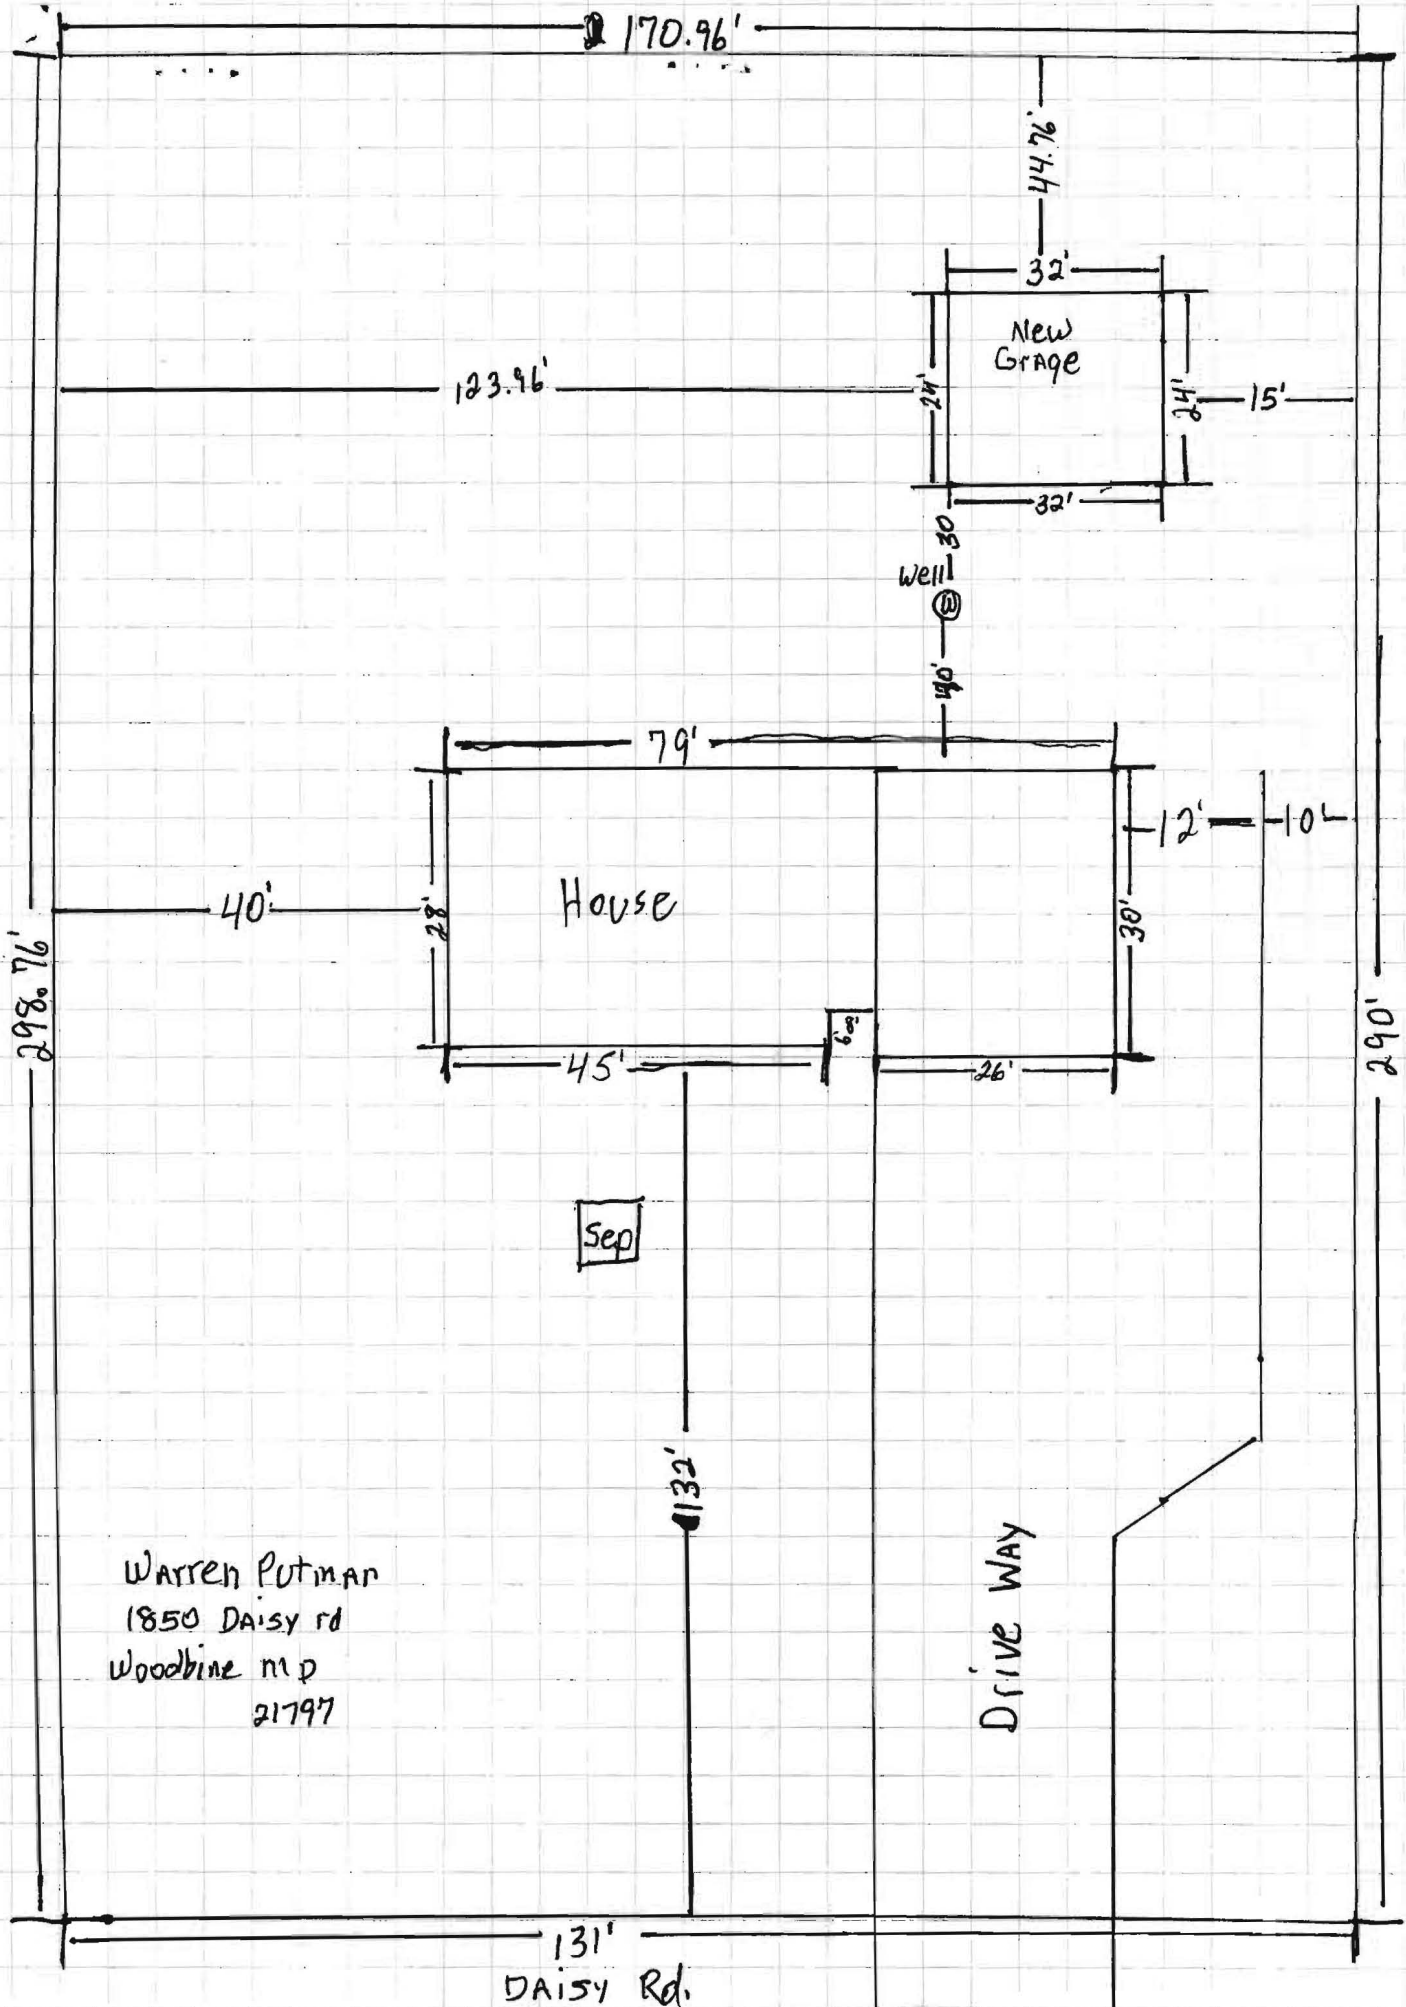

Warren Putman  
 1850 DAISY rd  
 Woodbine MD  
 21797