

P520400c

APPLICATION

A 16592

SEWAGE DISPOSAL TESTING

P _____

MARYLAND STATE DEPARTMENT OF HEALTH

HOWARD COUNTY Septic Tank - 1000 gal

ELLICOTT CITY

Dry Well - 300 sq ft located to southeast corner
to begin below the point 4 ft of ground
with maximum depth permitted for dry well
is 11 ft below original grade. Locate dry well
155 ft from left side line and 65 ft from road
determine the same when it is necessary to

DISTRICT 5

DATE 12/10/71

TO: THE COUNTY HEALTH OFFICER
ELLICOTT CITY, MARYLAND

I, HEREBY, APPLY FOR THE NECESSARY TESTS IN ORDER TO CONSTRUCT (OR RECONSTRUCT) A SEWAGE DISPOSAL SYSTEM.

PROPERTY OWNER Richard M. Hallowell

ADDRESS _____ PHONE _____

PROPERTY LOCATION:

SUBDIVISION _____ LOT NO. Parcel 4

ROAD AND DESCRIPTION 7000
Brooks Road off Rt. 108 - will flag with red flag on pole

OCCUPANT _____ PHONE _____

PERSON TO CONSTRUCT SYSTEM _____

ADDRESS _____ PHONE _____

SIZE OF LOT 8.500 acres TYPE BLDG. 3

IF NOT SINGLE RESIDENCE DESCRIBE _____ (Single Fmly. Dwllg.)

This will be a 3 bedroom home and
will have a nursery in the basement
for 6 to 8 children.

SIGNATURE OF APPLICANT [Signature] Patricia J. Perlman

APPROVED BY [Signature] FOR [Signature] DATE 11/7/72

REJECTED BY _____ FOR _____ DATE _____

HOLD PENDING FURTHER TESTS _____ DATE _____

REASONS FOR REJECTION OR HOLDING _____

ALC592

Per. In. at - Parkhigh T. at

Ed Willson Bldg
7749675

Brooks P.

355.00

Parcel
5,500 Acres

961.711

1321.00

1257.72

Driveway

EXIST. AT TIME OF TEST 490.5'

EXIST. EL 490'

Inv. Dry Well 489'

EXIST. EL 492


Inv. Tank 490'

Inv. EL 491'

FF 500

FF 492


EXIST. EL Well 502'

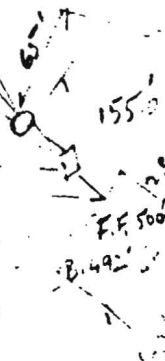

3/21/72


Approved. R. Turner

116598

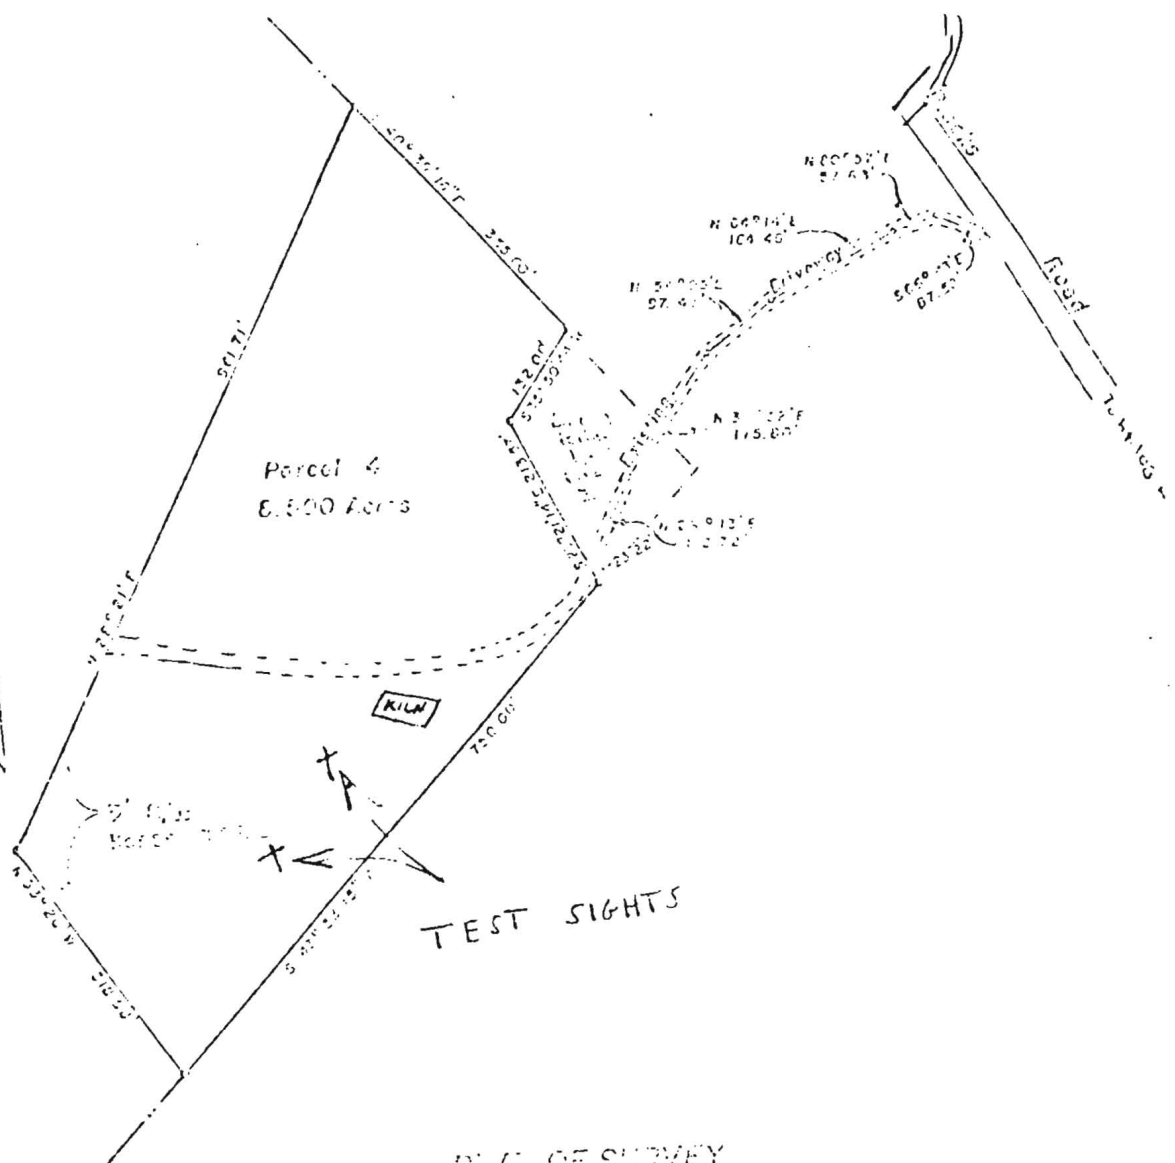

PLAN OF SURVEY
 FOR
 RICHARD M. HALLOWELL
 FIFTH ELECTION DISTRICT OF HOWARD COUNTY
 HIGHLAND, MARYLAND
 SCALE: 1 INCH = 200 FT
 JANUARY 2, 1971

George W. ...
 Surveyor
 License No. ...

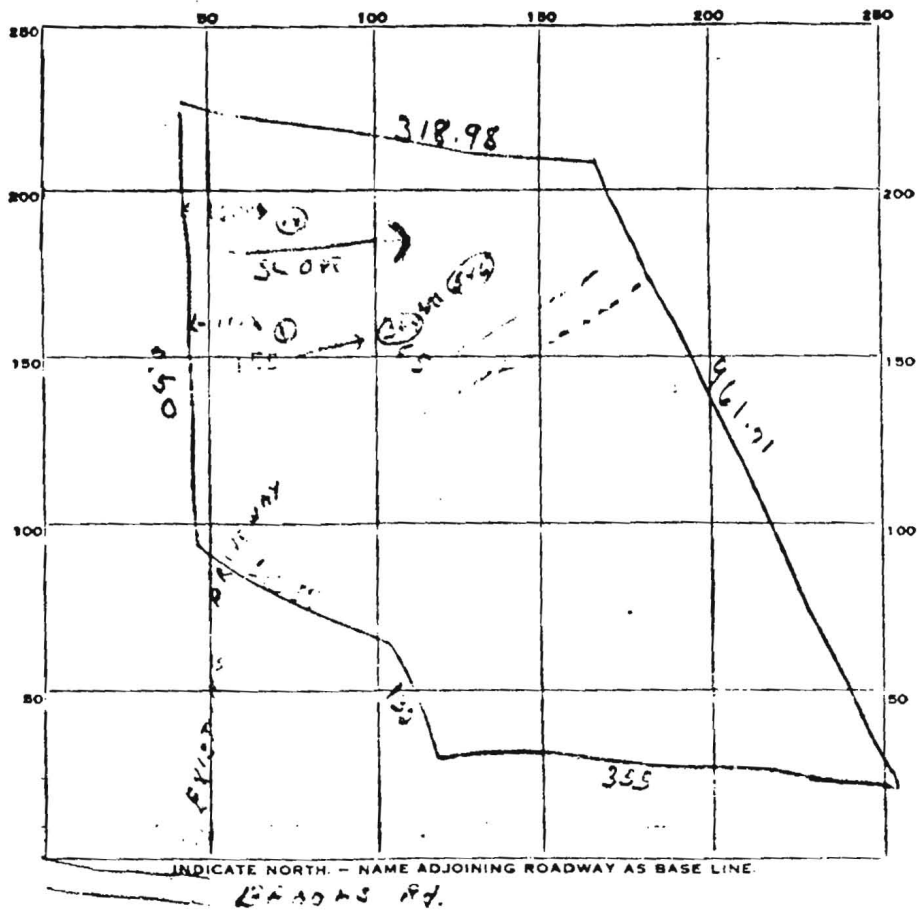

DATE	TEST NO.	DEPTH	PRE-WET		TEST - 1" DROP		TIME
			START	STOP	START	STOP	
	1	9ft	12:20				
	2	5ft	12:20				
	3	14ft	12:20	12:25	12:30	12:32	4 min
	4	8ft	12:25	12:32	12:32	12:40	8 min
	5	3ft	12:30	12:35	12:35	12:40	5 min
	6	10ft	12:32	12:40	12:40	12:45	5 min

SOIL AUGER FINDING _____

TESTED BY _____