

PUB. SEWER STATUS VERIFIED BY \_\_\_\_\_

ISSUE DATE: \_\_\_\_\_

APPROVAL DATE: \_\_\_\_\_

# PERMIT INDEXED

P 520402-B

A RE-INDEX

## ON-SITE SEWAGE DISPOSAL SYSTEM HOWARD COUNTY HEALTH DEPARTMENT BUREAU OF ENVIRONMENTAL HEALTH

IS PERMITTED TO INSTALL  ALTER

ADDRESS: \_\_\_\_\_ PHONE NUMBER: \_\_\_\_\_

SUBDIVISION: Briar Hill LOT NUMBER: 20

ADDRESS: 3491 Blackberry Lane PROPERTY OWNER: <sup>GLENN</sup> Gaynor

SEPTIC TANK CAPACITY (GALLONS): \_\_\_\_\_

PUMP CHAMBER CAPACITY (GALLONS): \_\_\_\_\_

NUMBER OF BEDROOMS: \_\_\_\_\_

SQUARE FEET PER BEDROOM: \_\_\_\_\_

LINEAR FEET OF TRENCH REQUIRED: \_\_\_\_\_

TRENCHES:	Trench to be _____ feet wide. Inlet _____ feet below original grade. Bottom maximum depth _____ feet below original grade. Effective area begins at _____ feet below original grade. _____ feet of stone below distribution pipe.
LOCATION:	
PURPOSE:	Reindex file 7/30/04

PLANS APPROVED: \_\_\_\_\_ DATE: \_\_\_\_\_

- NOTE: PERMIT VOID AFTER 2 YEARS
- NOTE: CONTRACTOR RESPONSIBLE FOR SCHEDULING A PRE-CONSTRUCTION INSPECTION FOR ALL INSTALLATIONS
- NOTE: WATERTIGHT SEPTIC TANKS REQUIRED
- NOTE: ALL PARTS OF SEPTIC SYSTEM SHALL BE 100 FEET FROM ANY WATER WELL
- NOTE: MANHOLE RISERS REQUIRED ON ALL SEPTIC TANKS AND PUMP CHAMBERS

NEITHER THE HOWARD COUNTY COUNCIL OR THE HEALTH DEPARTMENT IS  
 RESPONSIBLE FOR THE SUCCESSFUL OPERATION OF ANY SYSTEM  
 PERMITTEE RESPONSIBLE FOR OBTAINING FINAL APPROVAL ON THIS PERMIT  
 CALL 410-313-2640 FOR INSPECTION OF SEPTIC SYSTEM

**BUILDING PERMIT SIGNED  
 AND RETURNED**

4/22/04 800147636 SCREENED PORCH / DECK

P 520402-B

SEPTIC SYSTEM MUST BE INSTALLED  
FIRST BEFORE BUILDING PERMIT  
CAN BE SIGNED.

# PERMIT

SEWAGE DISPOSAL SYSTEM

MARYLAND STATE DEPARTMENT OF HEALTH

HOWARD COUNTY

ELLICOTT CITY

DISTRICT 3rd

DATE 1/2/79

P 29362

A 20758

**INDEXED**

Olen Ketterman

IS PERMITTED TO INSTALL  ALTER

ADDRESS 6119 Jerry's Drive, Columbia, Md. 21044

PHONE 997-8740

SUBDIVISION Briar Hill

ROAD Blackberry Lane

LOT 8 (new 3)

PROPERTY OWNER Briar Hill Corporation

ADDRESS 3901 Gelding Lane, Olney, Md. 20832

Phone: 774-0647

SPECIFICATIONS 4 bedrooms

SEPTIC TANK CAPACITY 1250 GALLONS

DRAIN FIELD \_\_\_\_\_ DEPTH \_\_\_\_\_ FEET. BOTTOM AREA \_\_\_\_\_ SQ. FT.

DEEP TRENCH \_\_\_\_\_ DEPTH \_\_\_\_\_ FEET. BOTTOM AREA \_\_\_\_\_ SQ. FT.

SEEPAGE PITS  ABSORBENT SIDE WALL AREA 120 SQ. FT. sidewall area per bedroom.

INLET PIPE 3 1/2 FT. BELOW ORIGINAL GRADE. MAXIMUM DEPTH 11 FT. BELOW ORIGINAL GRADE

EFFECTIVE DEPTH AT \_\_\_\_\_ FT. BELOW ORIGINAL GRADE

LOCATE DISPOSAL AREA 25 FT. FROM front LOT LINE AND 160 FT. FROM left LOT LINE AS SEEN WHEN FACING LOT FROM the front.

BLDG. PERMIT SIGNED  
AND RETURNED 1/9/79  
serial # 38074

PLANS APPROVED BY Donald W. Monaghan

DATE 1/13/77

COVER NO WORK UNTIL INSPECTED AND APPROVED

NEITHER THE HOWARD COUNTY COUNCIL NOR THE HEALTH DEPARTMENT IS RESPONSIBLE FOR THE SUCCESSFUL OPERATION OF ANY SYSTEM

NOTE IF TRENCH IS USED CALL FOR INSPECTION BEFORE PLACING GRAVEL IN TRENCH

NOTE NO DRY WELL SHALL EXCEED 18 FEET IN DIAMETER 1/2/79 ok for well to be 16' long

NOTE ALL PIPE FROM HOUSE TO DISPOSAL AREA MUST BE CAST IRON

PERMIT VOID AFTER THREE YEARS

NOTE INSTALL STAND PIPE ON SEPTIC TANK AND DRY WELL. STAND PIPES MUST BE 6 INCHES IN DIAMETER. CAST IRON, CONCRETE OR TERRAZO ACCEPTED


INSTALLER IS RESPONSIBLE FOR OBTAINING FINAL APPROVAL ON THIS PERMIT.

A 20758

*1/2/79  
2 p.m. please*

*APPROVED  
1/2/79*

20758

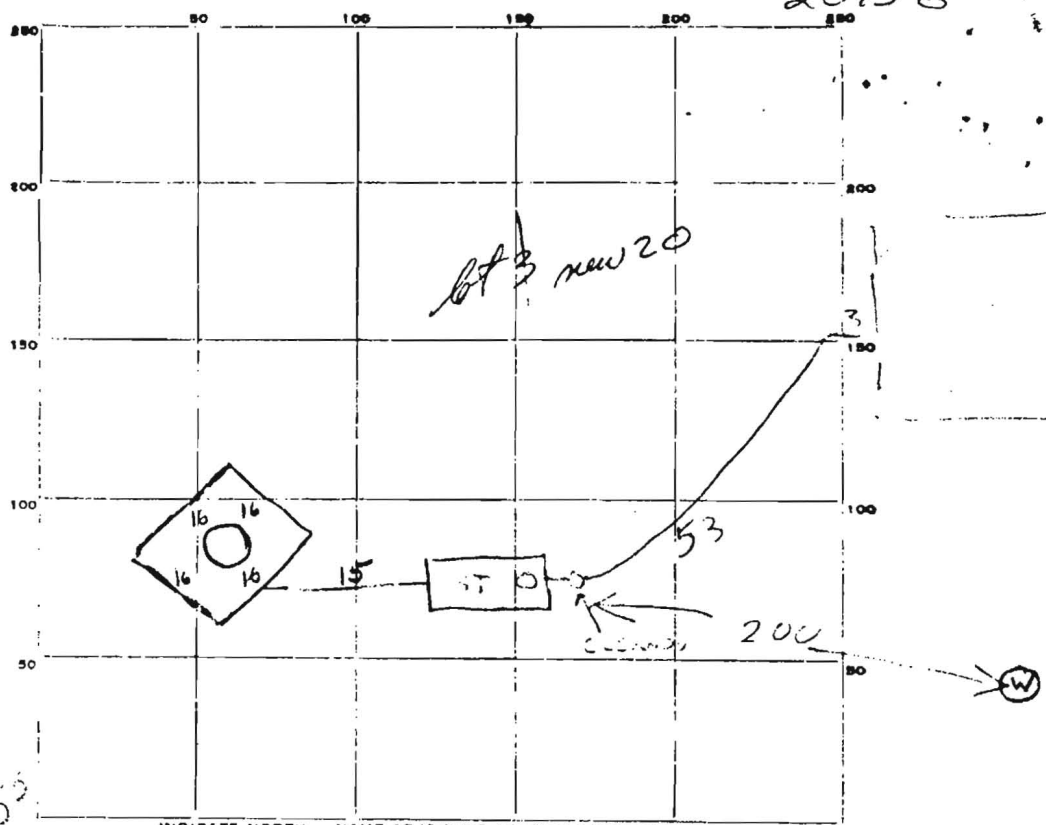

64  
 x 7.5  
 ---  
 330  
 443  
 ---  
 4770

INDICATE NORTH - NAME ADJOINING ROADWAY AS BASE LINE

BLACKBERRY LA

PERMIT CARD \_\_\_\_\_

SEPTIC TANK, LEVEL 1250 CLEANOUTS 

ST	DW
✓	✓

 CAST IRON

DISTRIBUTION BOX, LEVEL Na

TILE FIELD, DEPTH Na FT. TRENCH WIDTH \_\_\_\_\_ FT.

GRAVEL DEPTH \_\_\_\_\_ IN. TOTAL LENGTH \_\_\_\_\_ FT.

NUMBER OF TRENCHES \_\_\_\_\_ TOTAL BOTTOM AREA \_\_\_\_\_

SEEPAGE PITS, ~~WIDE DIAMETER~~ <sup>PERIMETER</sup> 64 FT. DEPTH BELOW INLET 7 1/2 FT.

ABSORBENT AREA +470 SQ. FT.

REMARKS 9 JAN 79 - call for final when house connection installed.  
OK to backfill (GLD)  
2/6/79 NO HOUSE YET RH.  
1/26/79 - HOUSE SET

DATE SYSTEM APPROVED 11/1/79 INSPECTOR [Signature]