

P520402-B

DEPARTMENT OF INSPECTIONS, LICENSES AND PERMITS
300 COURT HOUSE DRIVE
ELICOTT CITY, MARYLAND
PERMITS AND INSPECTIONS (410) 313-1910
AUTOMATED INFORMATION (410) 313-3089

HOWARD COUNTY PERMIT APPLICATION

PERMIT NUMBER

200147626

Building Address 3491 Blackberry Ln.
Ellicott City, Md. 21116-21042

Suite/Apt. #: _____ SDP/WP/Petition #: _____

Census Tract 662000 Subdivision BRIDGE HILL

Section _____ Area _____ Lot 20

Tax Map _____ Parcel _____ Grid _____

Zoning _____ Map Coordinates 10D8 Lot size _____

Property Owner's Name Glenn Gaynor

Address 3491 Blackberry Ln. 21042

City Ellicott City State MD Zip Code 21116

Home Phone 443-535-8440 Work Phone 410-850-5900

Applicant's Name & Mailing Address, (if other than stated hereon): _____

Phone _____ Fax _____

Existing Use Residential

Proposed Use _____

Estimated Construction Cost \$ \$35,000.00

Description of Work Build a 10' x 14' screen porch / deck on rear of house - total footage - 750 ± (2' x 10' - 2.5' slope)

Contractor Company Top Notch Contracting

Contact Person Jim Bauch

Address 3979 Hunkes Hill Rd

City New Windsor State MD Zip Code 21776

License No. 76989

Phone 410-635-3388 Fax 410-635-8184

Occupant or Tenant Glenn Gaynor

Contact Name _____

Address 3491 Blackberry Ln

City Ellicott City State MD Zip Code 21042

Phone 443-535-8440 Fax _____

Engineer or Architect Company N/A

Contact Person _____

Address _____

City _____ State _____ Zip Code _____

Phone _____ Fax _____

BUILDING DESCRIPTION - COMMERCIAL

BUILDING DESCRIPTION - RESIDENTIAL

Building Characteristics	Utilities
Height: _____	Water Supply: _____ Public _____ Private _____
No. of stories: _____	Sewage Disposal: _____ Public _____ Private _____
Gross area, sq. ft. per floor: _____	Electric Yes <input type="checkbox"/> No <input type="checkbox"/>
Use group: _____	Gas Yes <input type="checkbox"/> No <input type="checkbox"/>
Construction type: _____ Reinforced Concrete _____ Structural Steel _____ Masonry _____ Wood Frame _____	Heating System: _____ Electric <input type="checkbox"/> Oil <input type="checkbox"/> Natural Gas <input type="checkbox"/> Propane Gas <input type="checkbox"/>
State Certified Modular _____	Sprinkler system: N/A <input type="checkbox"/> Full _____ Partial _____ Other Suppression _____ # of Heads _____

Building Characteristics	Utilities
SF Dwelling <input checked="" type="checkbox"/> SF Townhouse <input type="checkbox"/> Depth _____ Width _____	Water Supply: _____ Public _____ Private <input checked="" type="checkbox"/>
1st floor: _____	Sewage Disposal: _____ Public _____ Private <input checked="" type="checkbox"/>
2nd floor: _____	Electric Yes <input type="checkbox"/> No <input type="checkbox"/>
Basement: _____	Gas Yes <input type="checkbox"/> No <input type="checkbox"/>
Finished Basement <input type="checkbox"/> Unfinished Basement <input type="checkbox"/>	Heating System: _____ Electric <input type="checkbox"/> Oil <input type="checkbox"/> Natural Gas <input type="checkbox"/> Propane Gas <input type="checkbox"/>
Crawl space <input type="checkbox"/> Slab on Grade <input type="checkbox"/>	Sprinkler system: N/A <input type="checkbox"/> NFPA #13D _____ NFPA #13R _____ Other: _____
No. of Bedrooms _____	
Multi-family dwellings: _____ No. of efficiency units: _____ No. of 1 BR units: _____ No. of 2 BR units: _____ No. of 3 BR units: _____	
Other Structure: _____	
Dimensions: _____	
Footings: _____	
Roof: _____	
State Certified Modular _____ Manufactured Home _____	

THE UNDERSIGNED HEREBY CERTIFIES AND AGREES AS FOLLOWS: (1) THAT HE/SHE IS AUTHORIZED TO MAKE THIS APPLICATION, (2) THAT THE INFORMATION IS CORRECT, (3) THAT HE/SHE WILL COMPLY WITH ALL REGULATIONS OF HOWARD COUNTY WHICH ARE APPLICABLE THERETO, (4) THAT HE/SHE WILL PERFORM NO WORK ON THE ABOVE REFERENCED PROPERTY NOT SPECIFICALLY DESCRIBED IN THIS APPLICATION, (5) THAT HE/SHE GRANTS COUNTY OFFICIALS THE RIGHT TO ENTER ONTO THIS PROPERTY FOR THE PURPOSE OF INSPECTING THE WORK PERMITTED AND POSTING NOTICES.

James W. Bauch
Applicant's Signature

James W. Bauch
Print Name

Title/Company _____

Date 4/21/2004

Checks payable to: **DIRECTOR OF FINANCE OF HOWARD COUNTY**
** PLEASE WRITE NEATLY AND LEGIBLY. **
- FOR OFFICE USE ONLY -

AGENCY	DATE	SIGNATURE APPROVAL
Land Development, DPZ		
State Highways		
Building Official		
Dev. Engineering, DPZ		
Health	<u>4/22/04</u>	<u>[Signature]</u>
Fire Protection		

Is Sediment Control approval required prior to issuance?
YES NO

CONTINGENCY CONSTRUCTION START:

ONE STOP SHOP:

DPZ SETBACK INFORMATION

Front: _____

Rear: _____

Side: _____

Side St.: _____

All minimum setbacks met? YES NO

Is Entrance Permit required? YES NO

Historic District? YES NO

Lot Coverage for NewTown Zone _____

SDP/Red-line approval date _____

PROPERTY ID# 601740

Filing fee \$ _____

Permit fee \$ 35

Excise tax \$ N/A

Add'l per. fee \$ 4

TOTAL FEES \$ 39

Sub-total paid \$ _____

Balance due \$ _____

Check # 1374

Validation # _____

Accepted by _____

Distribution of Copies: White: Building Official Green: LDD, DPZ Yellow: DED, DPZ Pink: Health Gold: SHA

APPROVED

WALK-THRU BUILDING PERMIT

BP# 001473636 A#

APP SAN FA DATE: 4/2/09

DESC. OF WORK: _____

Deck
Back of House

P
R
CH

90'

75'

50' x 75'

3

100'


Well

3491 Blackberry Ln

Tin = 20'

- NOTE: 1) This plat is of benefit to a consumer only insofar as it may be required by a lender or a title insurance company or its agent in connection with contemplated transactions, financing or re-financing;
- 2) This plat is not to be relied upon for the establishment of location of fences, easements, buildings, or other existing or future improvements; and
- 3) This plat does not provide for the accurate identification of property boundaries. However, such identification may not be required for transfer of interests in securing financing or refinancing.
- 4) The bearing, distance and accuracy of apparent setback distances is one to three orders of less.

NOTE: The property shown hereon is located within Zone C2 as shown on F.E.M.A. Flood Insurance Rate Map, Community Plan No. 240041-0021 B of Howard County, Maryland (Unincorporated Areas) dated: 12/6/1985.

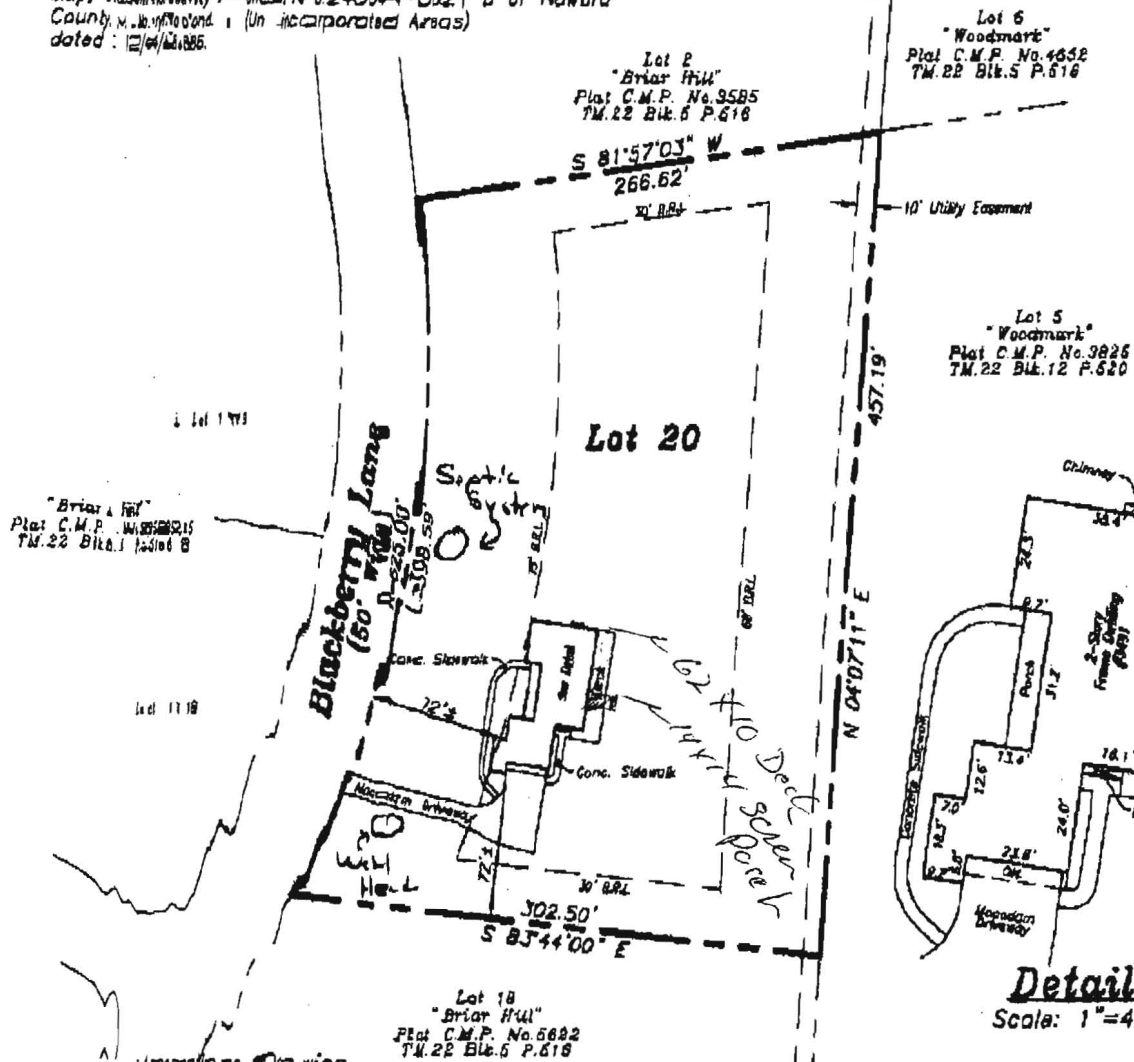

Maximum Drawing
Lot 20
 "Briar Hill Station 1"
 Plat C.M.P. No. 5622
 Dened Liber 5548 Folio 377
 Tax Map 202 Block 5 Parcel 516
 Scale: 1" = 100' March 9, 2004
 Howard County, Maryland

BOYD & DOWGIALLO, P.A.
 ENGINEERS*SURVEYORS*PLANNERS
 7697B Quorum Field Road
 Suite 201
 Glen Burnie, Maryland 21051
 (410) 8963-1234

CERTIFICATION:
 This is to certify that I have surveyed the property shown hereon for the purpose of locating the improvements and the improvements are located as shown.

Boyd & Dowgiallo, P.A., Reg. No. 171

Barry D. Pyle
 Barry D. Pyle
 MD Professional Land Surveyor #21117
 Date 3/9/04