

PUB. SEWER STATUS VERIFIED BY \_\_\_\_\_

ISSUE DATE: 5/19/64

APPROVAL DATE: \_\_\_\_\_

# PERMIT

## INDEXED

P 520400-c

A RE-INDEX

### ON-SITE SEWAGE DISPOSAL SYSTEM HOWARD COUNTY HEALTH DEPARTMENT BUREAU OF ENVIRONMENTAL HEALTH

IS PERMITTED TO INSTALL  ALTER

ADDRESS: \_\_\_\_\_ PHONE NUMBER: \_\_\_\_\_

SUBDIVISION: Greenwood Farms LOT NUMBER: 15

ADDRESS: 7466 Brown Bridge Road PROPERTY OWNER: Stone

SEPTIC TANK CAPACITY (GALLONS): \_\_\_\_\_

PUMP CHAMBER CAPACITY (GALLONS): \_\_\_\_\_

NUMBER OF BEDROOMS: \_\_\_\_\_

SQUARE FEET PER BEDROOM: \_\_\_\_\_

LINEAR FEET OF TRENCH REQUIRED: \_\_\_\_\_

TRENCHES:	Trench to be _____ feet wide. Inlet _____ feet below original grade. Bottom maximum depth _____ feet below original grade. Effective area begins at _____ feet below original grade. _____ feet of stone below distribution pipe.
LOCATION:	_____
PURPOSE:	Reindex file 7/30/04

PLANS APPROVED: \_\_\_\_\_ DATE: \_\_\_\_\_

- NOTE: PERMIT VOID AFTER 2 YEARS
- NOTE: CONTRACTOR RESPONSIBLE FOR SCHEDULING A PRE-CONSTRUCTION INSPECTION FOR ALL INSTALLATIONS
- NOTE: WATERTIGHT SEPTIC TANKS REQUIRED
- NOTE: ALL PARTS OF SEPTIC SYSTEM SHALL BE 100 FEET FROM ANY WATER WELL
- NOTE: MANHOLE RISERS REQUIRED ON ALL SEPTIC TANKS AND PUMP CHAMBERS

**NEITHER THE HOWARD COUNTY COUNCIL OR THE HEALTH DEPARTMENT IS  
RESPONSIBLE FOR THE SUCCESSFUL OPERATION OF ANY SYSTEM  
PERMITTEE RESPONSIBLE FOR OBTAINING FINAL APPROVAL ON THIS PERMIT  
CALL 410-313-2640 FOR INSPECTION OF SEPTIC SYSTEM**

**BUILDING PERMIT SIGNED  
AND RETURNED**

6/4/04 800148608 GARAGE

520400-c

House Location Plat  
 Lot 15 Section Two  
 "GREENWOOD FARMS"  
 HOWARD County, Maryland  
 Scale: 1" = 40'

*Get 4 copies*

Engineer's Certificate

We hereby certify that we have carefully surveyed the improvements on the property as shown by this plat and that there are no encroachments on either side of property lines except as shown.


Maddox & Hopkins  
 Engineers & Surveyors

Plat Book  
 Plat

By: *[Signature]*

These changes have been made as of August 23, 1968  
 BEN DYER ASSOCIATES, INC.

By: *[Signature]*

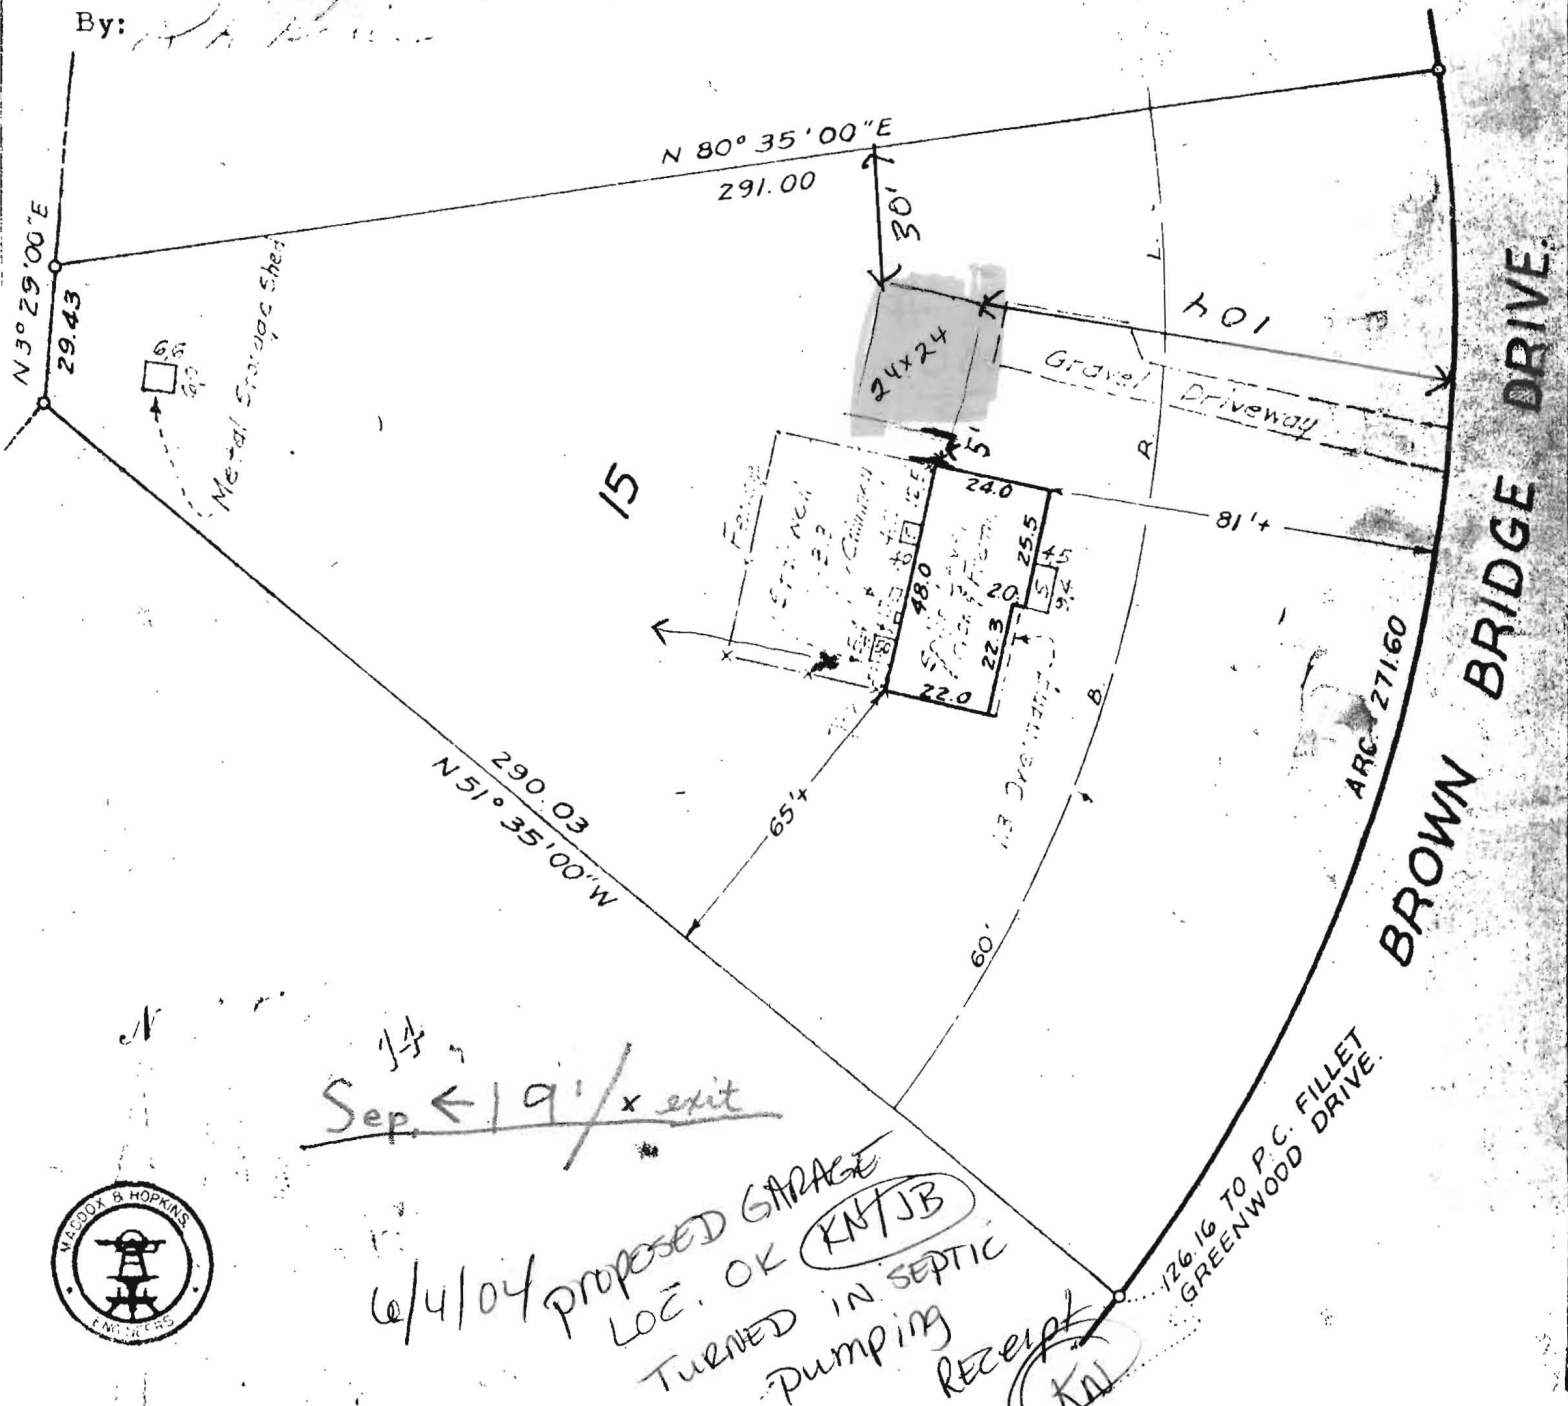

*Sep 19' x exit*

*6/4/04 PROPOSED GARAGE  
 LOC. OK (KNT/JB)  
 TURNED IN SEPTIC  
 PUMPING RECEIPT (KNT)*



**JACK FYOCK SEPTIC SERVICE, INC.**

SEPTIC PUMPING, INSTALLATION, AND REPAIRS

P.O. BOX 89 • GLENELG, MD 21737

PHONE (410) 988-9270 or (410) 531-2939

FAX: (410) 531-1256

Date 6/4/04

Name Stone

Address: 7466 Brown Bridge Rd.

City Highland Md. 20777

Invoice # 627604

Description

\$130.00 Pump Septic Tank only;  
\$140.00/2000 gallons. Additional on Saturday and  
after 4:00 p.m. daily.

Phone 301-854-2758

Time/Directions

*dm*

Total \$130.00

Pd. Ck. #

300

Total pumped

1000 gal. dm

Notice to the Customer

I understand that Fyock Septic Service is NOT responsible  
for any damage to the driveway or the lawn while rendering  
services on my property.

Customer Signature \_\_\_\_\_

Complete Sewer And Drain Service Now Available

\*\*\*\*\*Make Check Payable To Fyock\*\*\*\*\*

CUSTOMER COPY