

P520400-C

57  
6/1/64

# PERMIT

P 08448

SEWAGE DISPOSAL SYSTEM

A \_\_\_\_\_

MARYLAND STATE DEPARTMENT OF HEALTH

HOWARD COUNTY

ELLICOTT CITY

## INDEXED

DISTRICT 5

DATE 5/19/64

*Repair*

Elwood Seeger IS PERMITTED TO INSTALL \_\_\_\_\_ ALTER

ADDRESS RFD 1 - Box 267D - Laurel, Maryland PHONE PA 5-0324

A SEWAGE DISPOSAL SYSTEM LOCATED AT \_\_\_\_\_

SUBDIVISION GREENWOOD FARMS ROAD 7460 BROWN BRIDGE RD 15

PROPERTY OWNER Ensor, Chas A. At. 6-3349

ADDRESS Brown Bridge Road - 3rd house on right south of Rt. 216

### SPECIFICATIONS

DRAIN FIELD \_\_\_\_\_ DEPTH \_\_\_\_\_ FEET, BOTTOM AREA 300 SQ. FT.

SEEPAGE PITS \_\_\_\_\_ ABSORBENT SIDE-WALL AREA \_\_\_\_\_ SQ. FT.

SEPTIC TANK CAPACITY \_\_\_\_\_ GALLONS

FOR GARBAGE GRINDER, INCREASE DISPOSAL AREA 22% & TANK CAPACITY 50%.


OTHER addition to tile fields. - 300 sq ft.

PLANS APPROVED BY \_\_\_\_\_ DATE \_\_\_\_\_

FILL SEPTIC TANK AND DISTRIBUTION BOX WITH WATER BEFORE CALLING FOR AN INSPECTION. COVER NO WORK UNTIL INSPECTED AND APPROVED.

NEITHER THE HOWARD COUNTY COMMISSIONERS NOR THE HEALTH DEPARTMENT IS RESPONSIBLE FOR THE SUCCESSFUL OPERATION OF ANY SYSTEM.

*P 08448*

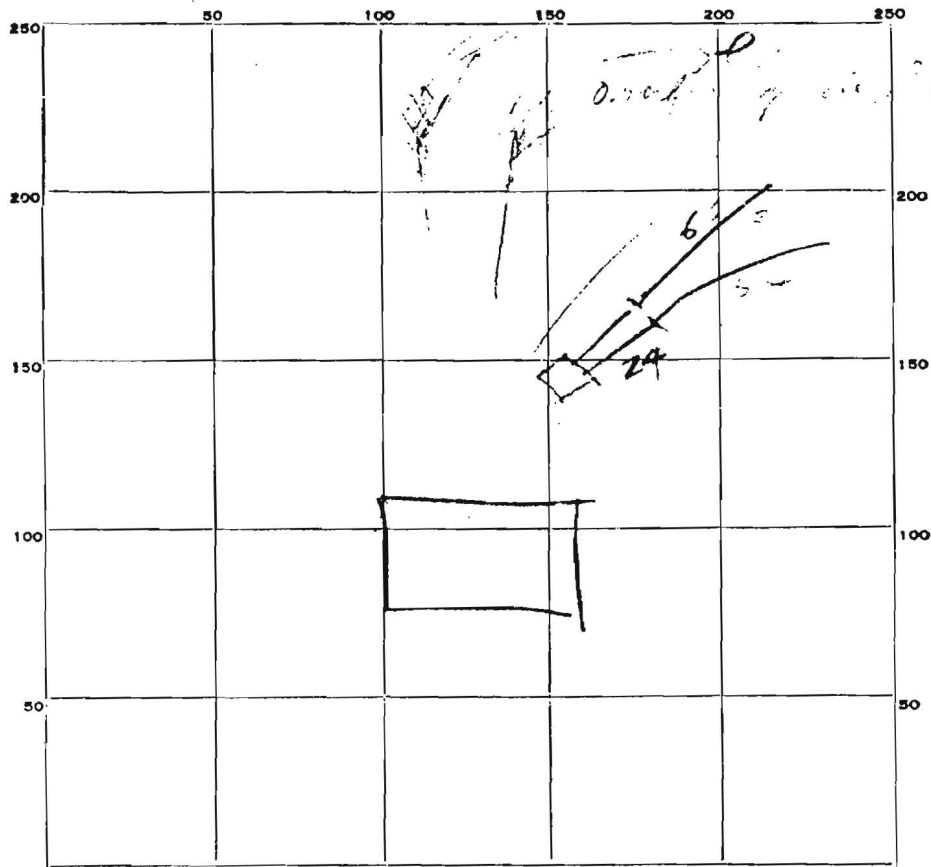

INDICATE NORTH. - NAME ADJOINING ROADWAY AS BASE LINE.

PERMIT CARD \_\_\_\_\_

SEPTIC TANK, LEVEL \_\_\_\_\_ CLEANOUTS \_\_\_\_\_

DISTRIBUTION BOX, LEVEL \_\_\_\_\_

TILE FIELD, DEPTH 4 1/2 FT. TRENCH WIDTH 5 FT.

GRAVEL DEPTH \_\_\_\_\_ IN. TOTAL LENGTH 114 FT.

NUMBER OF TRENCHES \_\_\_\_\_ TOTAL BOTTOM AREA 342

SEEPAGE PITS, INSIDE DIAMETER \_\_\_\_\_ FT. DEPTH BELOW INLET \_\_\_\_\_ FT.

ABSORBENT AREA \_\_\_\_\_ SQ. FT.

REMARKS

*Low soil system will probably not work well*

DATE SYSTEM APPROVED \_\_\_\_\_

INSPECTOR \_\_\_\_\_