

APPLICATION

A 22738

P _____

SEWAGE DISPOSAL TESTING

STATE OF MARYLAND - DEPARTMENT OF HEALTH AND MENTAL HYGIENE

HOWARD COUNTY HEALTH DEPARTMENT
ENVIRONMENTAL HEALTH SERVICES
P O BOX 476, ELLICOTT CITY, MARYLAND 21043
TELEPHONE 445-5000, EXT. 356

DISTRICT 1

DATE 1/19/76

TO: THE COUNTY HEALTH OFFICER
ELLICOTT CITY, MARYLAND

I, HEREBY, APPLY FOR THE NECESSARY TEST IN ORDER TO CONSTRUCT (OR RECONSTRUCT) A SEWAGE DISPOSAL SYSTEM.

PROPERTY OWNER G. A. Heidrick, Jr., et al

ADDRESS _____ PHONE Any questions call:
John Schneider
465-7777

PROPERTY LOCATION:

SUBDIVISION _____ LOT NO. _____

ROAD AND DESCRIPTION Eltham Drive - left on Eltham - go to lot left (which
has no name) toward Smithsonian
(2 or 3 cars will be there)

SIZE OF LOT 12 ACRES TYPE BLDG. 3 or 4
(LAND NOT BEING SUBDIVIDED) NUMBER OF BEDROOMS

IF NOT SINGLE RESIDENCE DESCRIBE _____

THE SYSTEM INSTALLED UNDER THIS APPLICATION IS ACCEPTABLE ONLY UNTIL PUBLIC FACILITIES BECOME AVAILABLE.

SIGNATURE OR APPLICANT /s/ John Schneider

APPROVED BY _____ FOR _____ DATE _____
(KIND OF SYSTEM)


REJECTED BY _____ FOR _____ DATE _____
(KIND OF SYSTEM)

HOLD PENDING FURTHER TESTS _____ DATE _____

REASONS FOR REJECTION OR HOLDING _____

THIS IS NOT A PERMIT

A 72738

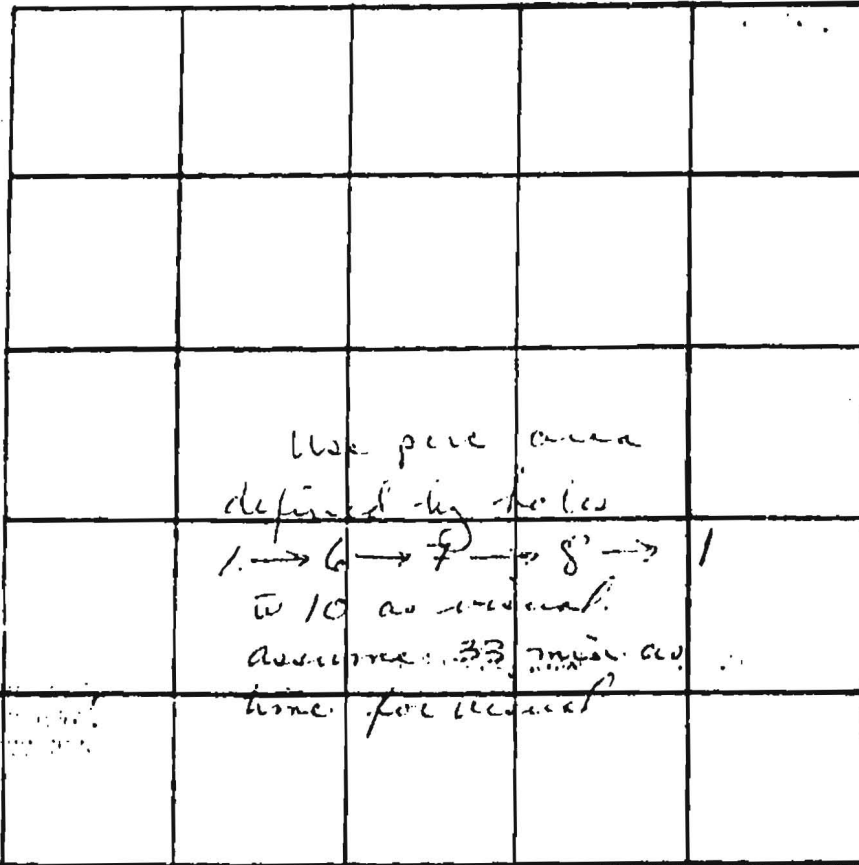

INDICATE NORTH - NAME ADJOINING ROADWAY AS BASE LINE.


DATE	TEST NO.	DEPTH	PRE-WET		TEST - 1" DROP		TIME	
			START	STOP	START	STOP		
	6 high	5	1:37	1:40	1:40	1:49	8	
	6-A	11½	1:37	1:50	1:50	2:10	20	
	7 low	5½	1:49	1:59	1:59	2:17	18	
	7-A	13	1:49	1:59	1:59	2:12	13	
	8	5½	2:04	2:10	2:10	2:23	13	
	8-H	12½	1:56	2:05	2:05	2:22	14	
2/10/76	9	13'	10:58	11:45	overland			
	10	6'	11:42	11:53	11:52	12:15	23 min	
	10	13½	Clay & silt to 5' sandy below					

assume 39

REMARKS (9) is clay to 6' sandy below in hollow

TYPE OF SOIL _____

TESTED BY F.S. W.W.Z. ALSO PRESENT: _____

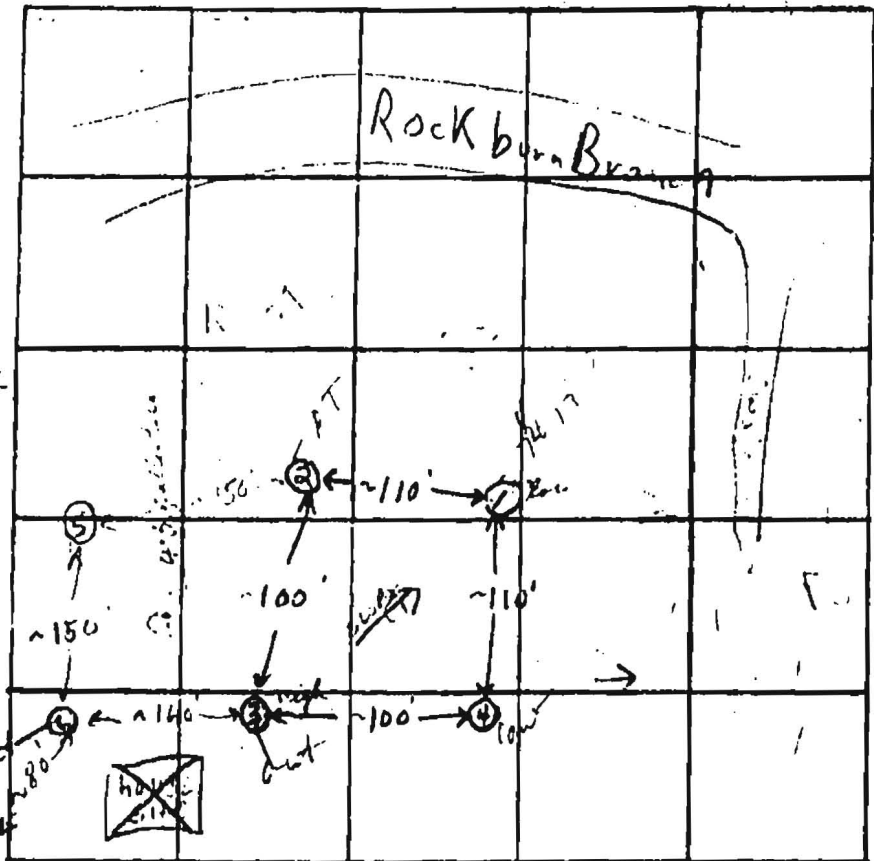

INDICATE NORTH - NAME ADJOINING ROADWAY AS BASE LINE.

DATE	TEST NO.	DEPTH	PRE-WET		TEST - 1" DROP		TIME
			START	STOP	START	STOP	
11/30/76	1 low	3 1/2'	1:59	pulled	2:21	1/4" drop	28 min
	1A	13 1/2'	1:50	2:10	2:10	2:38	28 min
	2	13'	Clay clay, low to 5' sandy loam below				
	3 high	4'	Clay clay, low to 3 1/2'				
	3A	13 1/2'	2:44	pulled		3:21	1/4" drop
	4	4'	2:30	pulled		3:03	1/2" drop
	4A	13'	2:24	pulled		3:03	1/2" drop
	1B	7 1/2'	3:04	3:21	3:21	3:42	21 min
	5	15'	3:44	4:02	4:02	4:31	23 min
2/5/76	6	12'	Water at 12' clay clay, loam				

REMARKS _____
 TYPE OF SOIL sandy loam below top 5' clay clay, loam
 TESTED BY F.S. ALSO PRESENT: OWNER & crew

APPLICATION

A 2273B

P _____

SEWAGE DISPOSAL TESTING

STATE OF MARYLAND - DEPARTMENT OF HEALTH AND MENTAL HYGIENE

HOWARD COUNTY HEALTH DEPARTMENT
ENVIRONMENTAL HEALTH SERVICES
P. O. BOX 476, ELLICOTT CITY, MARYLAND 21043
TELEPHONE: 465-3000, EXT. 356

DISTRICT 1DATE 1/19/76

TO: THE COUNTY HEALTH OFFICER
ELLICOTT CITY, MARYLAND

I, HEREBY, APPLY FOR THE NECESSARY TEST IN ORDER TO CONSTRUCT (OR RECONSTRUCT) A SEWAGE DISPOSAL SYSTEM.

PROPERTY OWNER G. A. Holderick, Jr., et al

ADDRESS _____

PHONE _____

Any questions call:
John Schneider
465-7777

PROPERTY LOCATION:

SUBDIVISION _____

LOT NO. _____

ROAD AND DESCRIPTION _____

Elbank Drive - left on Elbank - go to lot left (which
has no name) toward Smithsonian
(2 or 3 cars will be there)

SIZE OF LOT 12 ACRES

TYPE BLDG. _____

3 or 4

NUMBER OF BEDROOMS

IF NOT SINGLE RESIDENCE DESCRIBE _____
(LAND NOT BEING SUBDIVIDED)

THE SYSTEM INSTALLED UNDER THIS APPLICATION IS ACCEPTABLE ONLY UNTIL PUBLIC FACILITIES BECOME AVAILABLE.

SIGNATURE OF APPLICANT /s/ John Schneider

APPROVED BY _____

FOR _____

DATE _____

(KIND OF SYSTEM)

REJECTED BY _____

FOR _____

DATE _____

(KIND OF SYSTEM)

HOLD PENDING FURTHER TESTS _____

DATE _____

REASONS FOR REJECTION OR HOLDING _____

THIS IS NOT A PERMIT

connects below

