

PUB. SEWER STATUS VERIFIED BY \_\_\_\_\_

ISSUE DATE: 7/27/77

P 520400-B

APPROVAL DATE: \_\_\_\_\_

A RE-INDEX

# PERMIT INDEXED

## ON-SITE SEWAGE DISPOSAL SYSTEM HOWARD COUNTY HEALTH DEPARTMENT BUREAU OF ENVIRONMENTAL HEALTH

\_\_\_\_\_ IS PERMITTED TO INSTALL  ALTER

ADDRESS: \_\_\_\_\_ PHONE NUMBER: \_\_\_\_\_

SUBDIVISION: \_\_\_\_\_ LOT NUMBER: \_\_\_\_\_

ADDRESS: 6565 Belmont Woods Road PROPERTY OWNER: Gaynor

SEPTIC TANK CAPACITY (GALLONS): \_\_\_\_\_

PUMP CHAMBER CAPACITY (GALLONS): \_\_\_\_\_

NUMBER OF BEDROOMS: \_\_\_\_\_

SQUARE FEET PER BEDROOM: \_\_\_\_\_

LINEAR FEET OF TRENCH REQUIRED: \_\_\_\_\_

TRENCHES:	Trench to be _____ feet wide. Inlet _____ feet below original grade. Bottom maximum depth _____ feet below original grade. Effective area begins at _____ feet below original grade. _____ feet of stone below distribution pipe.
LOCATION:	
PURPOSE:	Reindex file 7/30/04

PLANS APPROVED: \_\_\_\_\_ DATE: \_\_\_\_\_

NOTE: PERMIT VOID AFTER 2 YEARS

NOTE: CONTRACTOR RESPONSIBLE FOR SCHEDULING A PRE-CONSTRUCTION INSPECTION FOR ALL INSTALLATIONS

NOTE: WATERTIGHT SEPTIC TANKS REQUIRED

NOTE: ALL PARTS OF SEPTIC SYSTEM SHALL BE 100 FEET FROM ANY WATER WELL

NOTE: MANHOLE RISERS REQUIRED ON ALL SEPTIC TANKS AND PUMP CHAMBERS

**NEITHER THE HOWARD COUNTY COUNCIL OR THE HEALTH DEPARTMENT IS  
RESPONSIBLE FOR THE SUCCESSFUL OPERATION OF ANY SYSTEM  
PERMITTEE RESPONSIBLE FOR OBTAINING FINAL APPROVAL ON THIS PERMIT  
CALL 410-313-2640 FOR INSPECTION OF SEPTIC SYSTEM**

**BUILDING PERMIT SIGNED**

**AND RETURNED**

6/24/2004 BOO149105 EXTEND DECK

P 520400-B

8320400-B

*Partial*  
*am. plan*

# PERMIT

*Approved*  
*9/19/77*  
*SD*

P 26497  
A 22738

SEWAGE DISPOSAL SYSTEM

MARYLAND STATE DEPARTMENT OF HEALTH

HOWARD COUNTY

ELLICOTT CITY

DISTRICT 1st

DATE 7/27/77

**INDEXED**

Howard International IS PERMITTED TO INSTALL X ALTER

ADDRESS 1700 North Rolling Road, Baltimore, Md. 21228 PHONE 265-5280

A SEWAGE DISPOSAL SYSTEM LOCATED AT \_\_\_\_\_

SUBDIVISION \_\_\_\_\_ ROAD Belmont Woods Road  
6565 Ellbank Drive LOT \_\_\_\_\_

PROPERTY OWNER George A. Heidrick, Jr. Mr. & Mrs. Kevin GAYNOR

ADDRESS 601 Oldsmont Road, Baltimore, Md. 21228 Phone: 747-3325

SPECIFICATIONS 3 bedrooms

DRAIN FIELD \_\_\_\_\_ DEPTH \_\_\_\_\_ FEET, BOTTOM AREA \_\_\_\_\_ SQ. FT.

SEEPAGE PITS \_\_\_\_\_ ABSORBENT SIDE-WALL AREA \_\_\_\_\_ SQ. FT.

SEPTIC TANK CAPACITY 1000 GALLONS

FOR GARBAGE GRINDER, INCREASE DISPOSAL AREA 22% & TANK CAPACITY 80%.

OTHER DRY WELL AND TRENCH - Dry well to have 360 sq. ft. effective absorbent sidewall area. Inlet at 4 ft. and maximum depth 11 ft. below original grade. Effective sidewall area does not begin until 5 ft. below original grade. Locate 20 ft. off left lot line (2238.75 ft.) and 850 ft. in from Smithsonian driveway. Trench to be 22 36 ft. long for a sidewall area of 216 sq. ft. Come off dry well and run trench more or less perpendicular to left lot line, toward pore hole #1, following contour to keep trench on as near level as possible. NOTE: CALL FOR INSPECTION OF TRENCH BEFORE PLACING STONE IN TRENCH. NOTE: ALL PIPE FROM HOUSE TO DISPOSAL AREA MUST BE CAST IRON. PERMIT VOID AFTER THREE YEARS. NOTE: INSTALL STAND PIPE ON SEPTIC TANK AND DRY WELL. STAND PIPES MUST BE 6 INCHES IN DIAMETER. CAST IRON,

PLANS APPROVED BY William W. Zepp DATE 3/2/76

CONCRETE OR TERRA COTTA ACCEPTED.

FILL SEPTIC TANK AND DISTRIBUTION BOX WITH WATER BEFORE CALLING FOR AN INSPECTION. COVER NO WORK UNTIL INSPECTED AND APPROVED.


NEITHER THE HOWARD COUNTY COMMISSIONERS NOR THE HEALTH DEPARTMENT IS RESPONSIBLE FOR THE SUCCESSFUL OPERATION OF ANY SYSTEM.

BLDG. PERMIT SIGNED

AND RETURNED 3/4/77

*Serial # 53605*  
*2 Story Addition*

*22738*

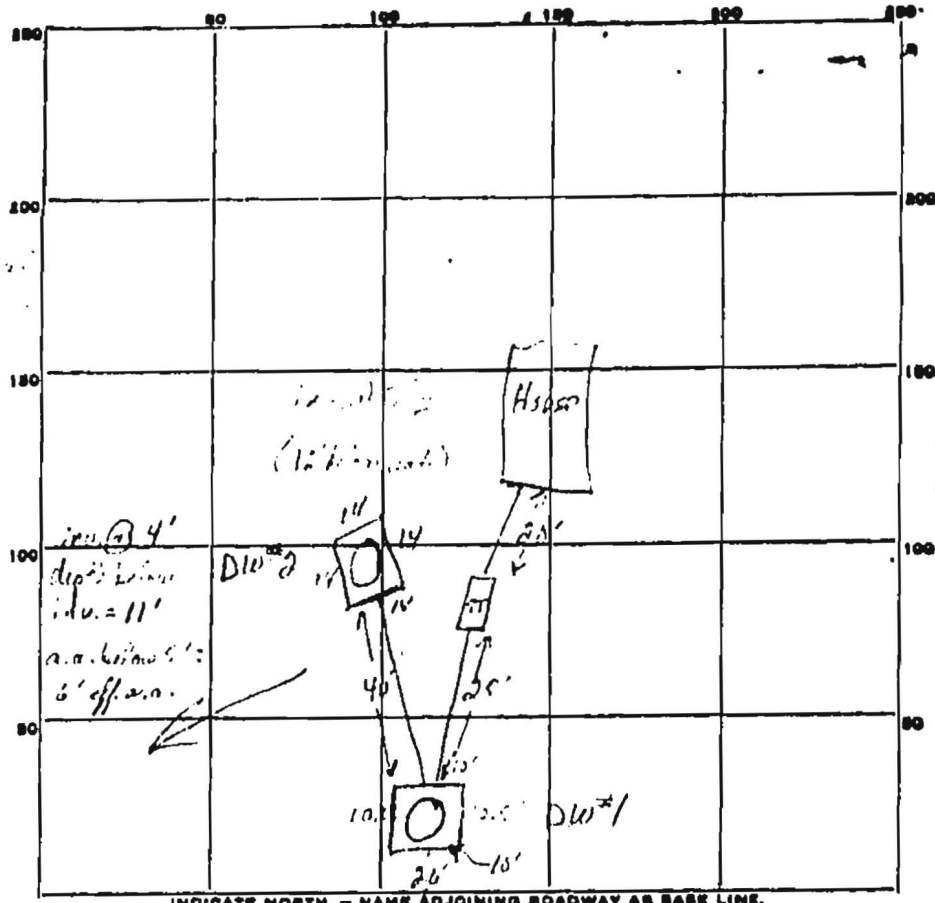

DW#1  
 10.5  
 10.5  
 10  
 10  
 41.0  
 6  
 246 ft<sup>2</sup>

Perim. = 56 ft<sup>2</sup>  
 max depth = 11'  
 minus 15' =  
 6' off a.a.  
 56  
 6  
 336 ft<sup>2</sup>  
 336  
 246  
 582 ft<sup>2</sup>

INDICATE NORTH - NAME ADJOINING ROADWAY AS BASE LINE.  
 North Property Line

PERMIT CARD  \_\_\_\_\_  
 SEPTIC TANK, LEVEL  \_\_\_\_\_ CLEANOUTS ST/DW1/DW2  
 DISTRIBUTION BOX, LEVEL \_\_\_\_\_  
 TILE FIELD, DEPTH \_\_\_\_\_ FT. TRENCH WIDTH \_\_\_\_\_ FT.  
 GRAVEL DEPTH \_\_\_\_\_ IN. TOTAL LENGTH \_\_\_\_\_ FT.  
 NUMBER OF TRENCHES \_\_\_\_\_ TOTAL BOTTOM AREA DW#1  
 BEEPAGE PITS, INSIDE DIAMETER Perimeter DW#1 41 FT. DEPTH BELOW INLET DW#1 6 FT.  
 ABSORBENT AREA DW#1 246 DW#2 336 SQ. FT. 582 ft<sup>2</sup> total

REMARKS T.S.O. 8/17/77: Add stone to DW#1, OK to cover up to DW#2. Add cap, cleanout, stone & call for final insp.

DATE SYSTEM APPROVED 8/17/77 INSPECTOR T.S.O. Osg